

Service No.

Name

Address #31 Moorbill Rd.

31 Moon Hill Rd.

Location

Kind of Pipe A.C.

Size 6"

Size of Main 8"

Repair—Renewal—New Service

Location

Date	Material	Amount	Total	Date	Amount
10-2-78	27' 6" A.C.P. @	\$19.00	\$513.00		
				10-2-78	
				27' 6" Transite	


DATE \_\_\_\_\_

TOWN OF LEXINGTON — BOARD OF PUBLIC WORKS

SEWER DIVISION

Sketch of Service Here

31

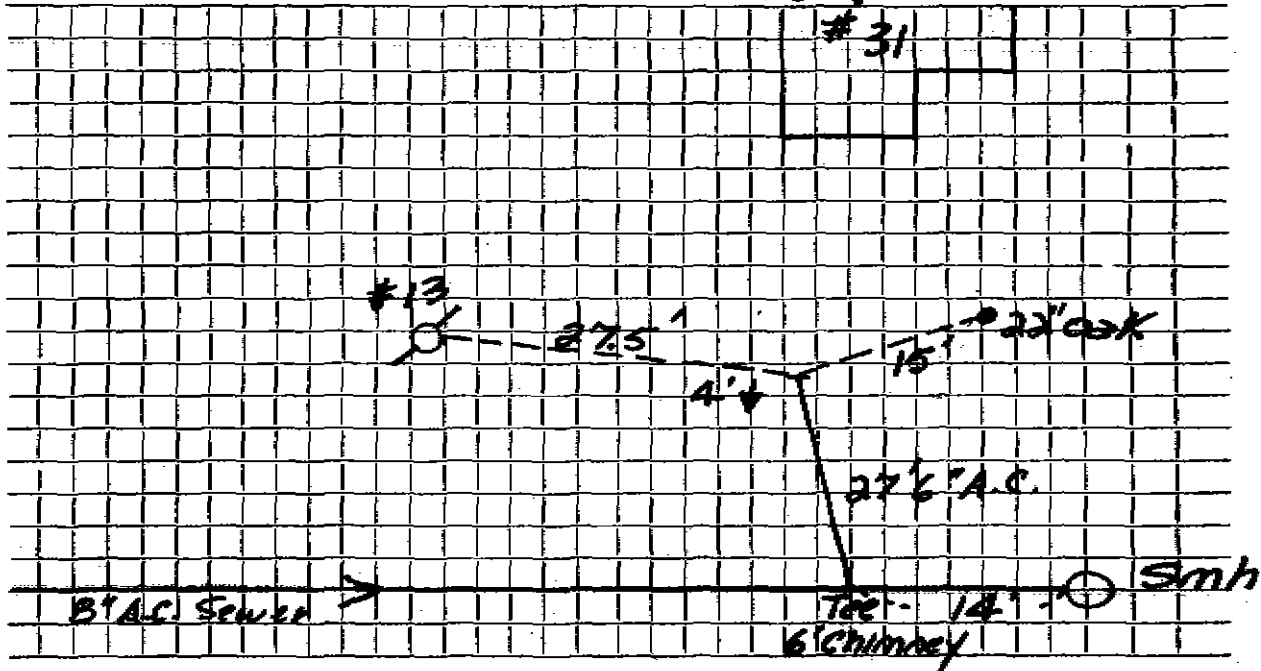

Connection made in ..... Street. Work completed .....

Remarks: .....

.....

.....