

Name

Service No.

Address # 33 Moonhill Rd.
33 Moon Hill Rd.

Location

Kind of Pipe A.C.

Size 6"

Size of Main 8"

Repair—Renewal—New Service

Location

Date	Material	Amount	Total	Date	Amount
10-6-78	R3'6" A.C.P.	\$ 19.00	\$ 437.00	10-6-78	
				29' 6" TRANSITS	

B.K. 18-01


DATE _____

TOWN OF LEXINGTON — BOARD OF PUBLIC WORKS

SEWER DIVISION

Sketch of Service Here

33

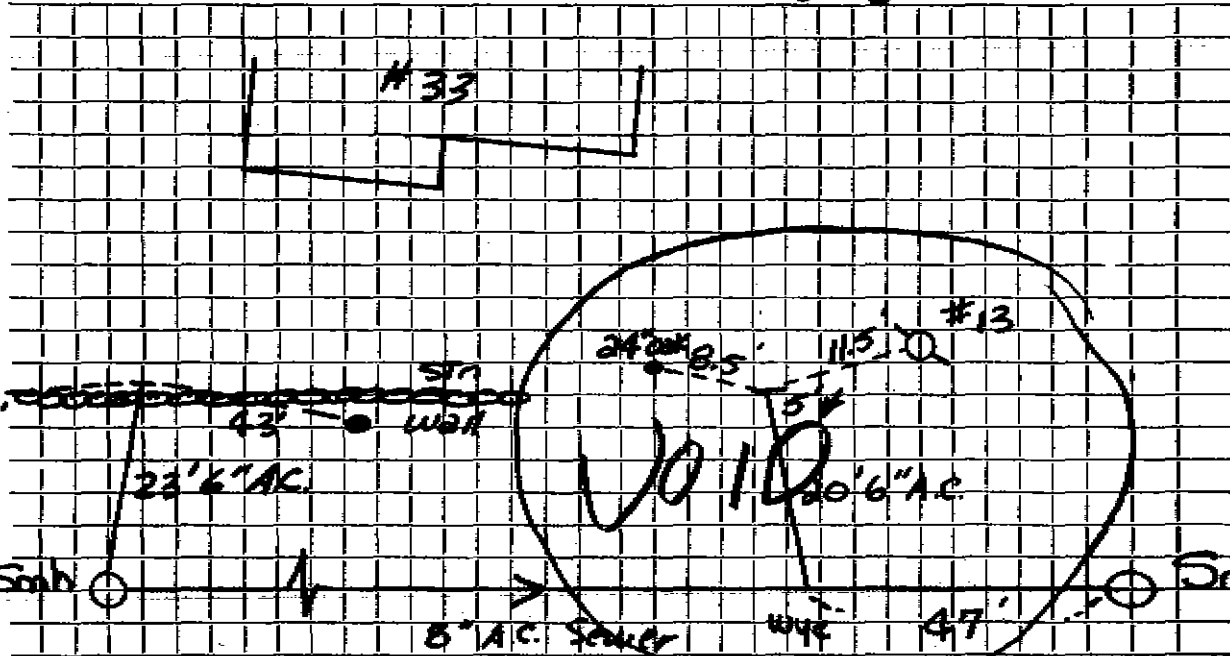

Note: Service out of S.H.H.

Connection made in Street. Work completed

Remarks:
.....
.....