

Name

Service No.

Address #34 Moorhill Rd.

34 Moon Mill Rd.

Location

Kind of Pipe A.C.

Size 6"

Size of Main 8"

Repair—Renewal—New Service

Location


Date	Material	Amount	Total	Date	Amount
8-17-78	15' 6" A.C.P.	\$19.00	\$285.00	10-12-78	
				15'	6" TRANSITE
				1	6" X 8" WYE

DATE _____

TOWN OF LEXINGTON — BOARD OF PUBLIC WORKS

SEWER DIVISION

Sketch of Service Here **34**

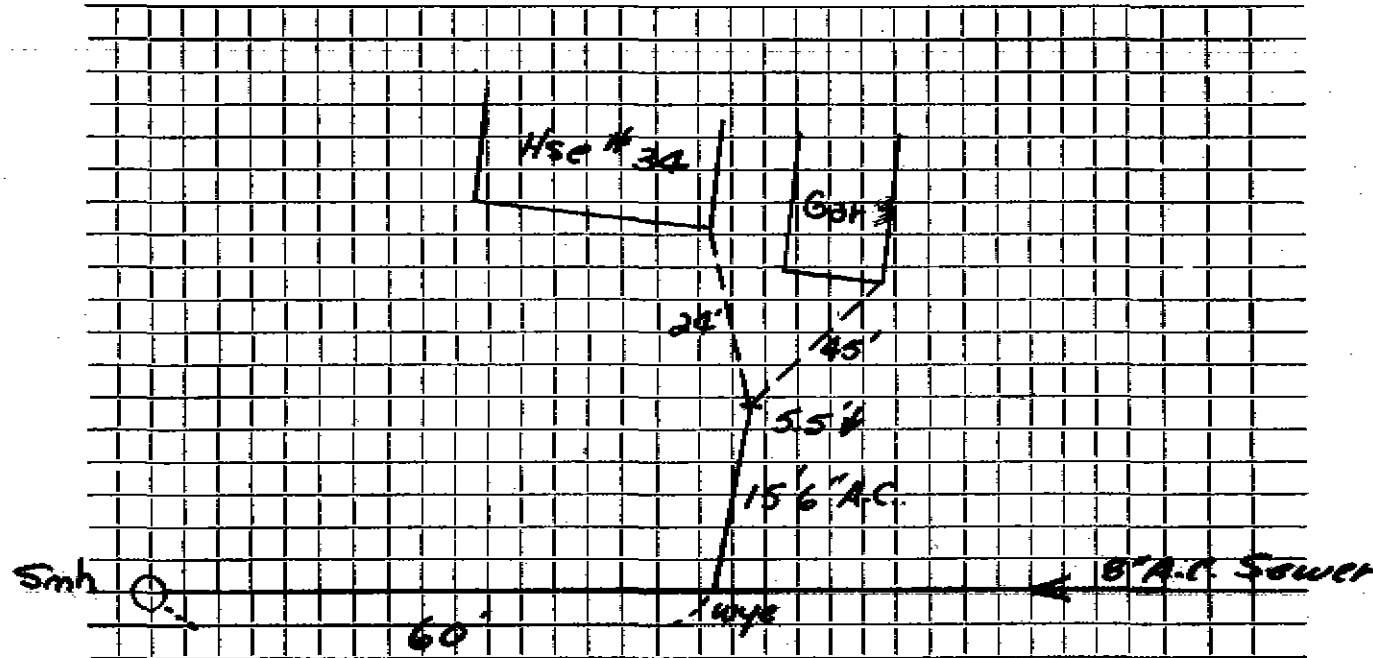

Connection made in Street. Work completed

Remarks:

.....

.....