


DATE _____

TOWN OF LEXINGTON — BOARD OF PUBLIC WORKS

SEWER DIVISION

Sketch of Service Here

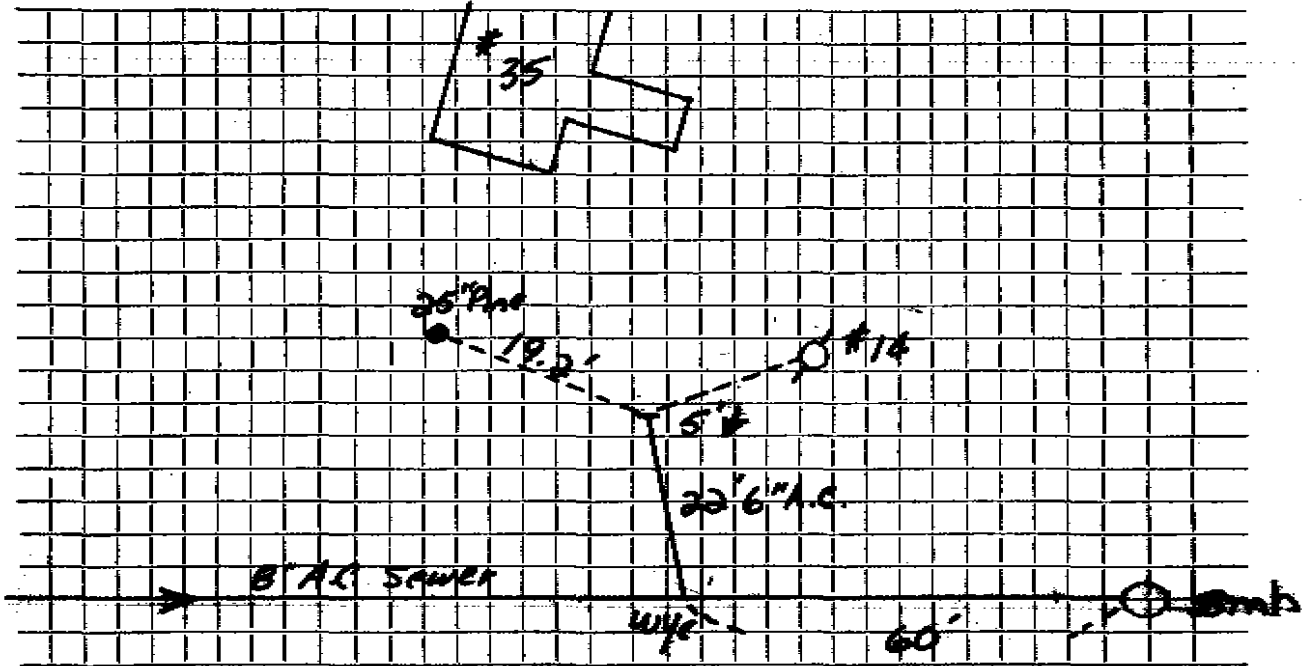

Connection made in Street. Work completed

Remarks:

.....

.....

FOUNDATION FOR ADDITION

DATE 7/29/96
5/8/97

TOWN OF LEXINGTON — BOARD OF PUBLIC WORKS

SEWER DIVISION


2' OF COVER
AT PNDTH

10.5'

4" PERNO

Sketch of Service Here

35

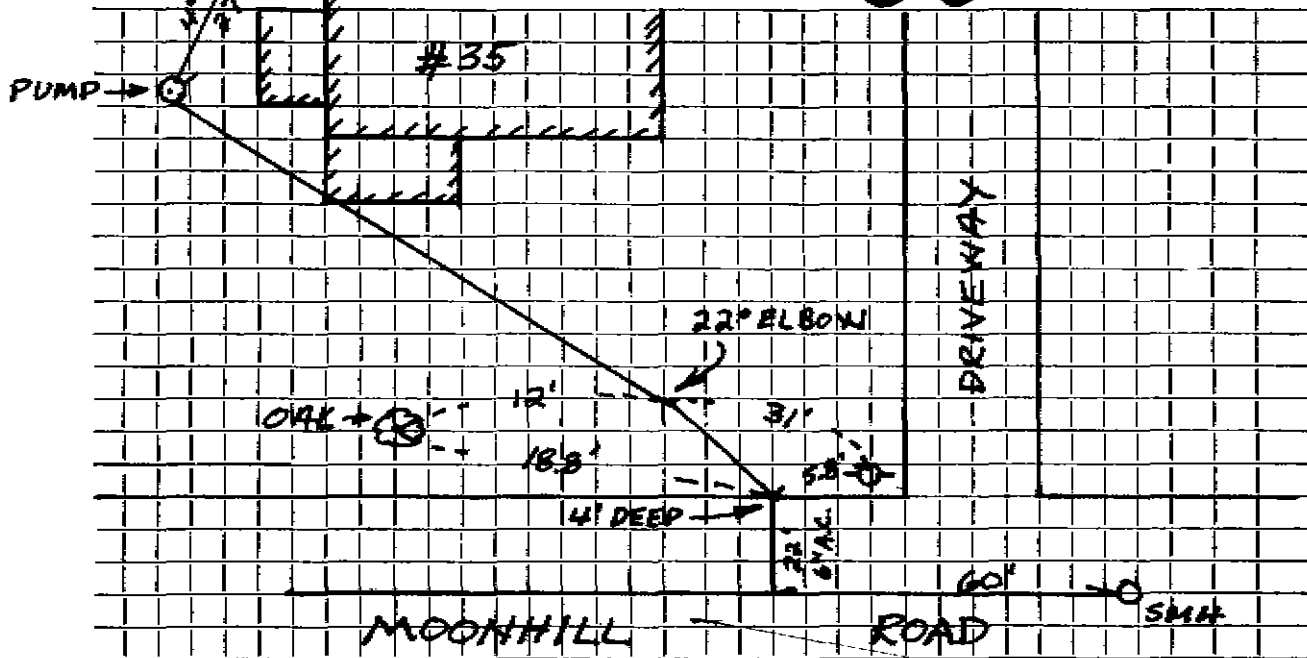

Connection made in MOONHILL ROAD Street. Work completed ARLEX OIL

Remarks: STUB AT STREET IS 3\"

PUMP INSTALLED. GRADE TO BE BUILD UP ALONG SEWER PIPE TO

PROVIDE 2' + COVER - ORIGINAL Service 10/12/78

BOOK 96-4 / BOOK 97-1

J.W.