

Name

Service No.

Address 37 Moon Hill Rd

37 Moon Hill Rd.

Location

Kind of Pipe AC

Size 6"

Size of Main 8"

Repair—Renewal—New Service

Location


Date	Material	Amount	Total	Date	Amount
<del>2-14-77</del>	<del>16' f-v-a-a D</del>	15.00	<del>240.00</del>	12-14-79	
				16' 6" TRANSITE	
				1 6" X 8" Wye	

DATE \_\_\_\_\_

TOWN OF LEXINGTON — BOARD OF PUBLIC WORKS  
SEWER DIVISION

Sketch of Service Here

37

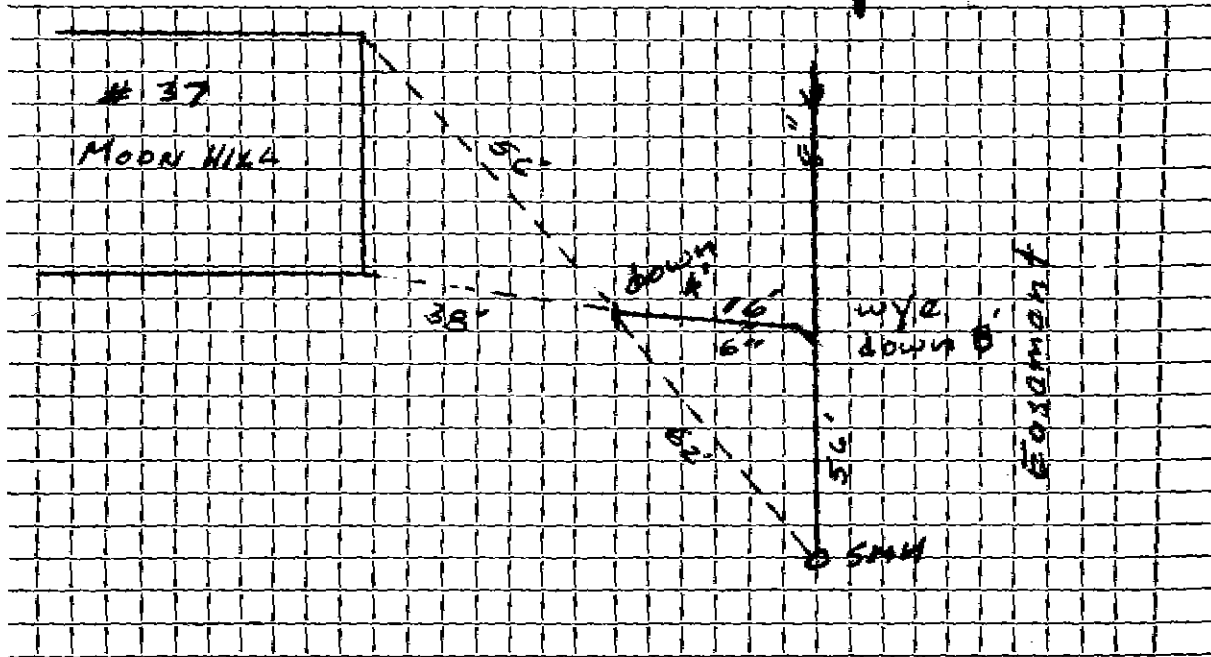

Connection made in Edgemont Street. Work completed .....

Remarks: .....  
.....  
.....