


DATE _____

TOWN OF LEXINGTON — BOARD OF PUBLIC WORKS

SEWER DIVISION

Sketch of Service Here

38

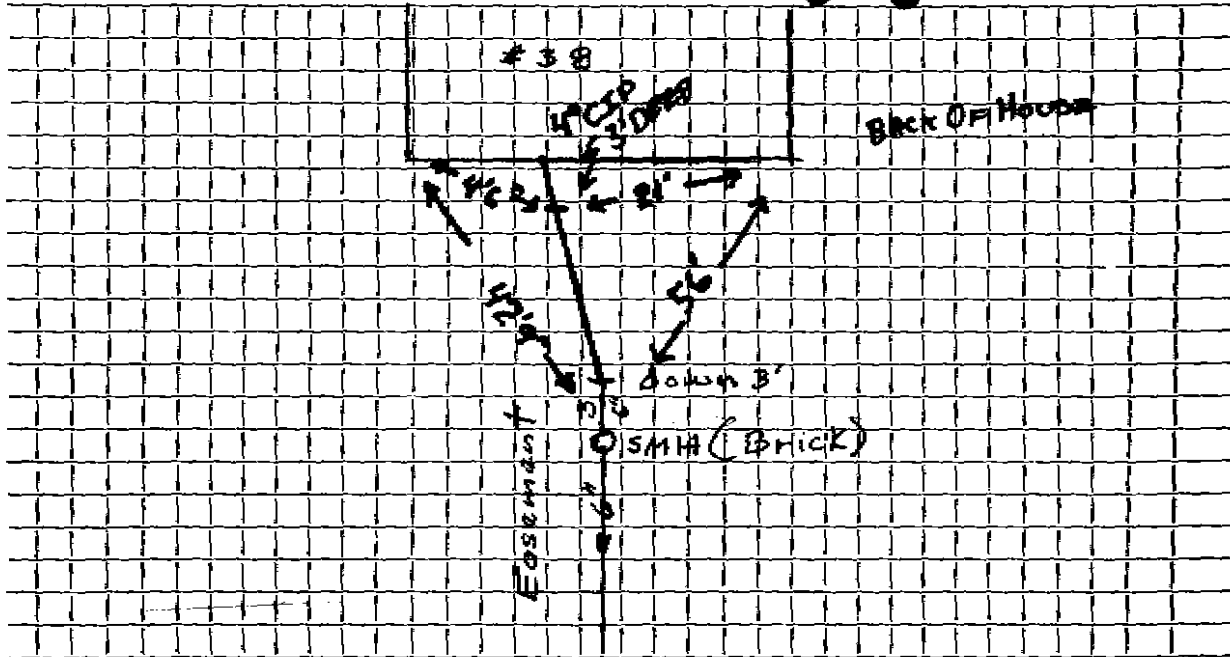

Connection made in Easement Street. Work completed

Remarks: 3' stub directly into H.H.

.....
.....