

Name Arthur Dempster

Service No. 71

Address #39 Moon Hill Rd

39 Moon Hill Rd.

Location

Kind of Pipe AC

Size 6"

Size of Main 8"


~~REPLACEMENT~~ New Service Great Northern #3550

Location NOV 24 1980

Date	Material	Amount	Total	Date	Amount
12-18-79	16' x 6" ACP @	15.00 =	240.00	11-5-80	DEPOSIT -240 ad
1-5-80	108' x 6" AC Pipe				
	1 6" x 6" Wye			12-18-79	
	2 6" x 4" Rubber Doughnut			16' 6" TRANSITE	

TOWN OF LEXINGTON — BOARD OF PUBLIC WORKS

SEWER DIVISION

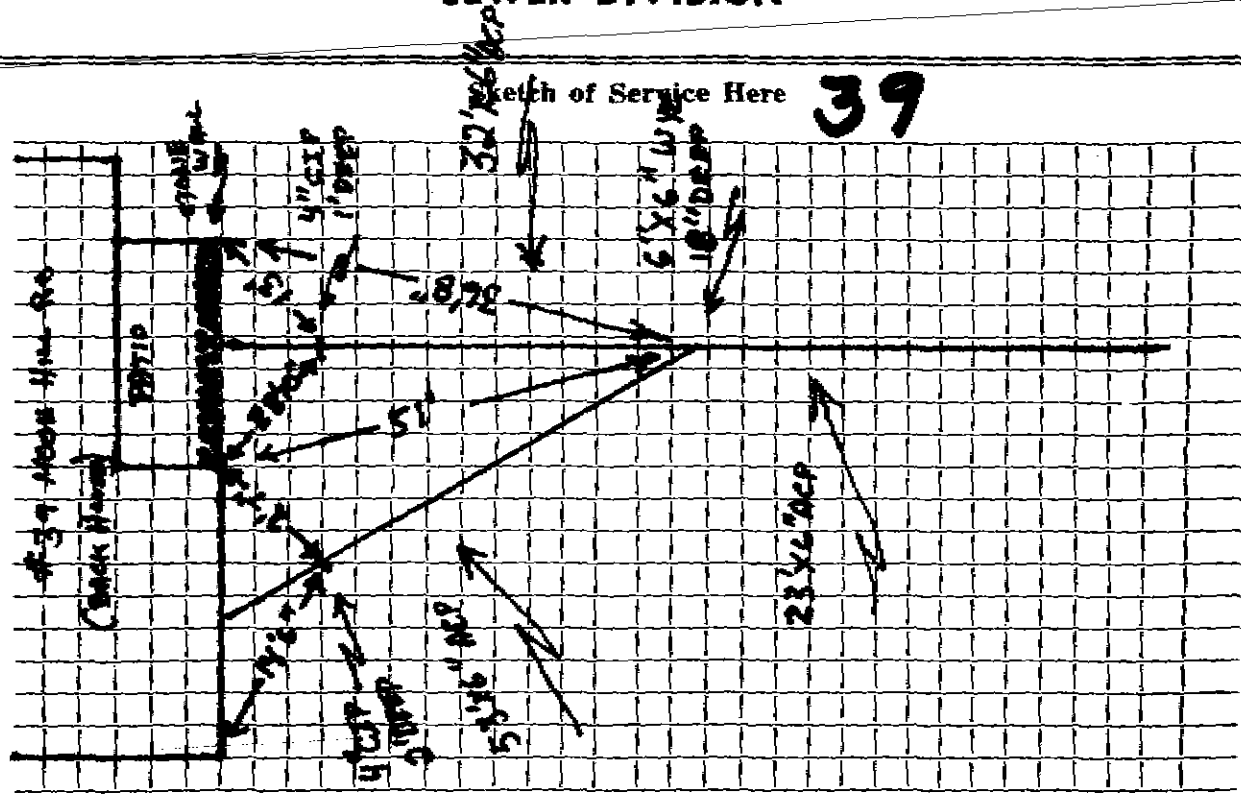

Connection made in ..... Street. Work completed .....

Remarks: .....

.....

.....