

1976

Name James Feeney

Service No. 71

Address 7 Moon Hill Road
4 Moonhill Rd.

JUN 20 1977

Location

Kind of Pipe

Size 6"

Size of Main 8"

~~Replacement~~ New Service


Kel-Scot #2990

Location

Date	Material	Amount	Total	Date	Amount
3-30-76	70' - 6" A.C.P.	0.00	200.00	5/30/76	Deposit
3-2	37' - 6" A.C.P.			3-30-76	
	3' - 4" C.I.				20' 6" Transit
					1 6" X 8" Wye

TOWN OF LEXINGTON — BOARD OF PUBLIC WORKS

SEWER DIVISION

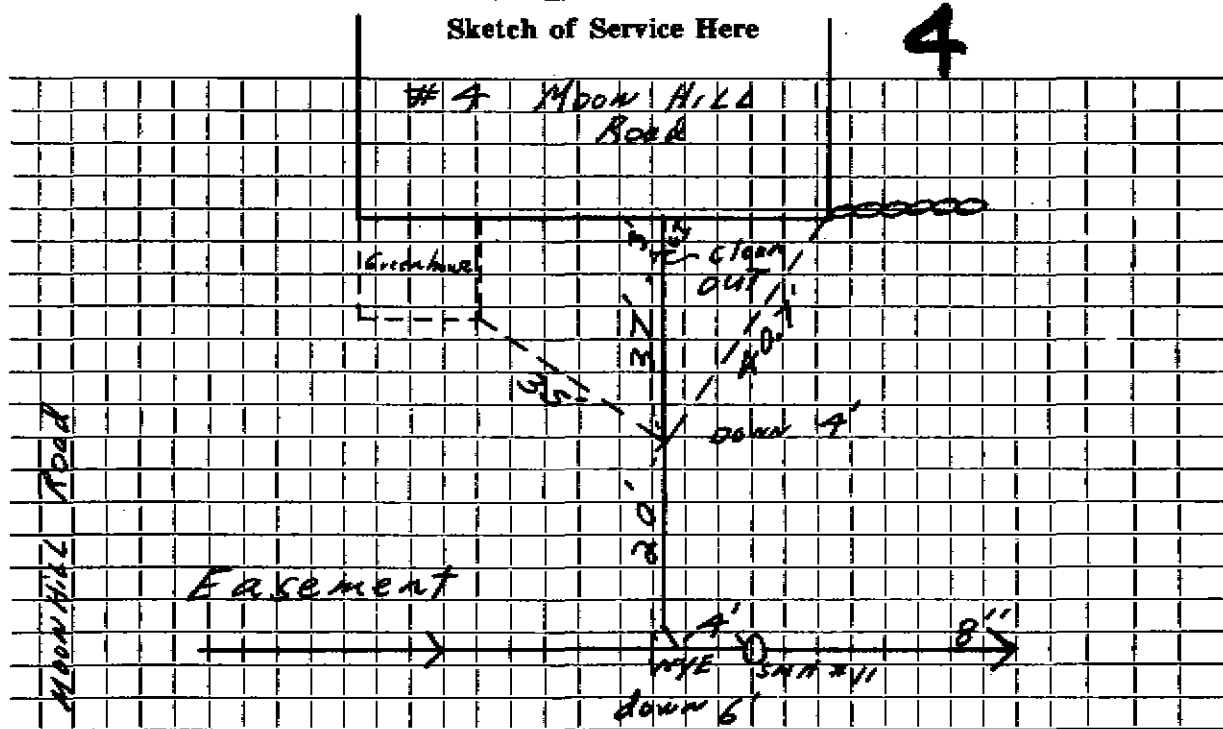

Connection made in Easement ~~Street~~ Work completed

Remarks:
.....
.....