


DATE _____

TOWN OF LEXINGTON — BOARD OF PUBLIC WORKS

SEWER DIVISION

Sketch of Service Here **40**

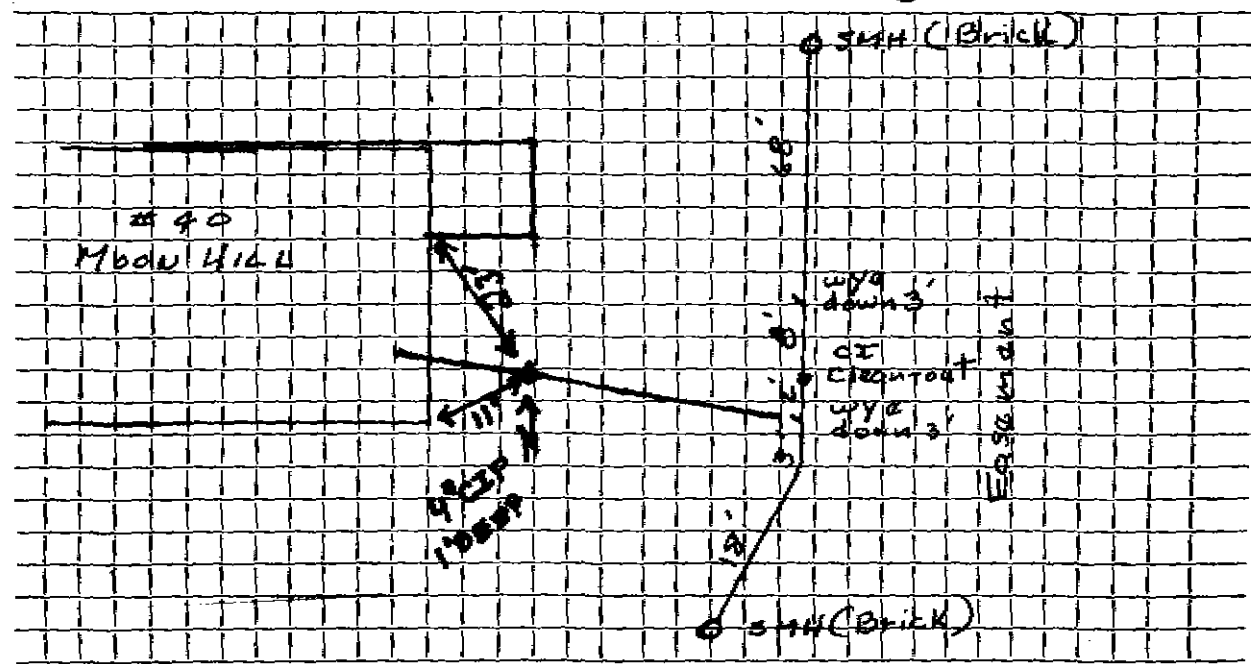

Connection made in Easement Street. Work completed

Remarks: No service pipe - 2 wyes

.....
.....