

Service No.

Address #5 Moorhill Rd.  
5 Moor Hill Rd.

Location

Kind of Pipe A.C.

Size 6"

Size of Main 8"


Repeat—Renewal—New Service PERMIT # 1011 - ARLEX OIL CO Location

Date	Material	Amount	Total	Date	Amount
<del>11-1-78</del>	<del>23' 6" PVC</del>	\$ 19.00	\$ 437.00		
9/24/1997	130'-6" PVC			11-1-78	
				23' 6" Transite	
				1 6" X 8" Wye	

DATE \_\_\_\_\_

TOWN OF LEXINGTON, — BOARD OF PUBLIC WORKS

SEWER DIVISION

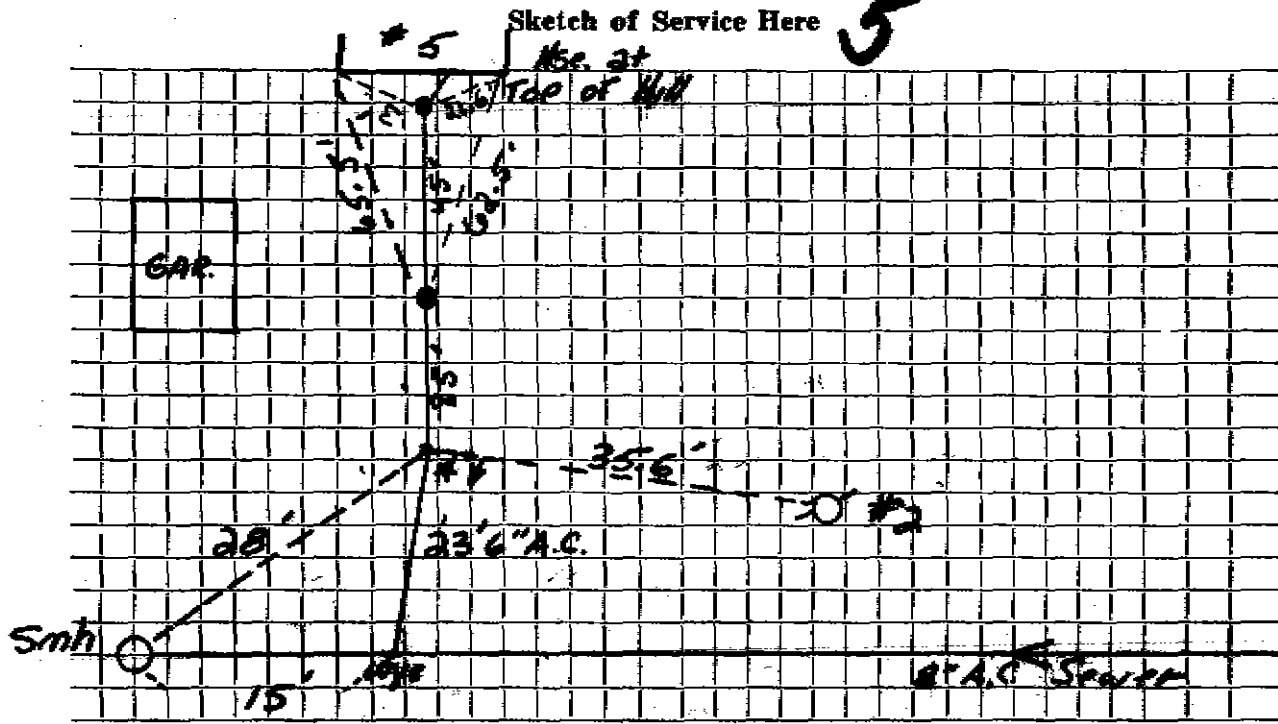

Connection made in ..... Street. Work completed .....

Remarks: .....

Book 97-3 .....