


6
 Sketch of Service Here
 # 6 Moon Road

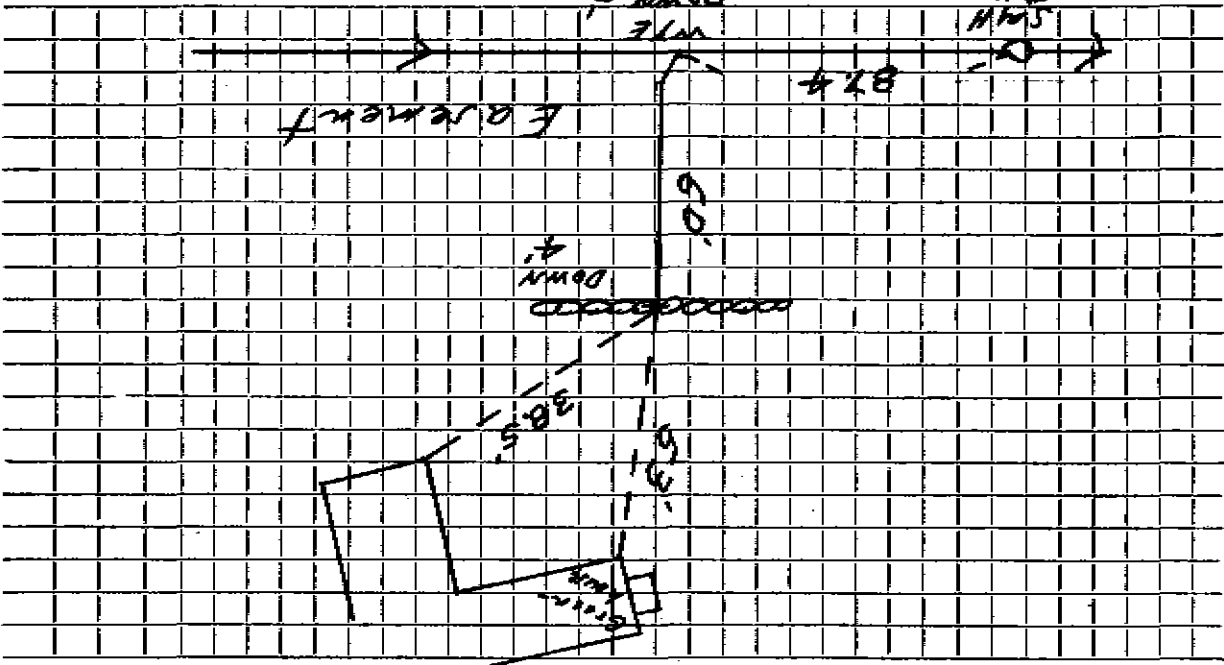

Work completed

Street

Connection made in

Easement

Remarks:

SEWER DIVISION

TOWN OF LEXINGTON — BOARD OF PUBLIC WORKS

DATE