

Name Mrs. Cooper

Service No.

Address 7 Moon Hill Road

7 Moon Hill Rd.

Location

Kind of Pipe A.C.

Size 6"

Size of Main 8"

~~Repair~~ ~~Renewal~~ New Service Kirkland #4814

Location


| Date              | Material                         | Amount | Total  | Date               | Amount            |
|-------------------|----------------------------------|--------|--------|--------------------|-------------------|
| <del>8/9/78</del> | <del>16' 6" A.C. @ \$19.00</del> |        | 304.00 | <del>4-17-89</del> | <del>304.00</del> |
| 4/11/89           | 82' 6" PVC                       |        |        |                    |                   |
|                   | 1 6 x 6 PVC to AC Ferraco        |        |        | 8-9-78             |                   |
|                   | 1 22° Coupling                   |        |        |                    | 16' 6" Transite   |
|                   | 1 45° Coupling                   |        |        |                    | 1 6" x 8" Wye     |
|                   | 1 4 x 6 PVC to CI Ferraco        |        |        |                    |                   |
|                   | 1 6' PVC Cap                     |        |        |                    |                   |

DATE \_\_\_\_\_

TOWN OF LEXINGTON — BOARD OF PUBLIC WORKS

SEWER DIVISION

Sketch of Service Here **7**

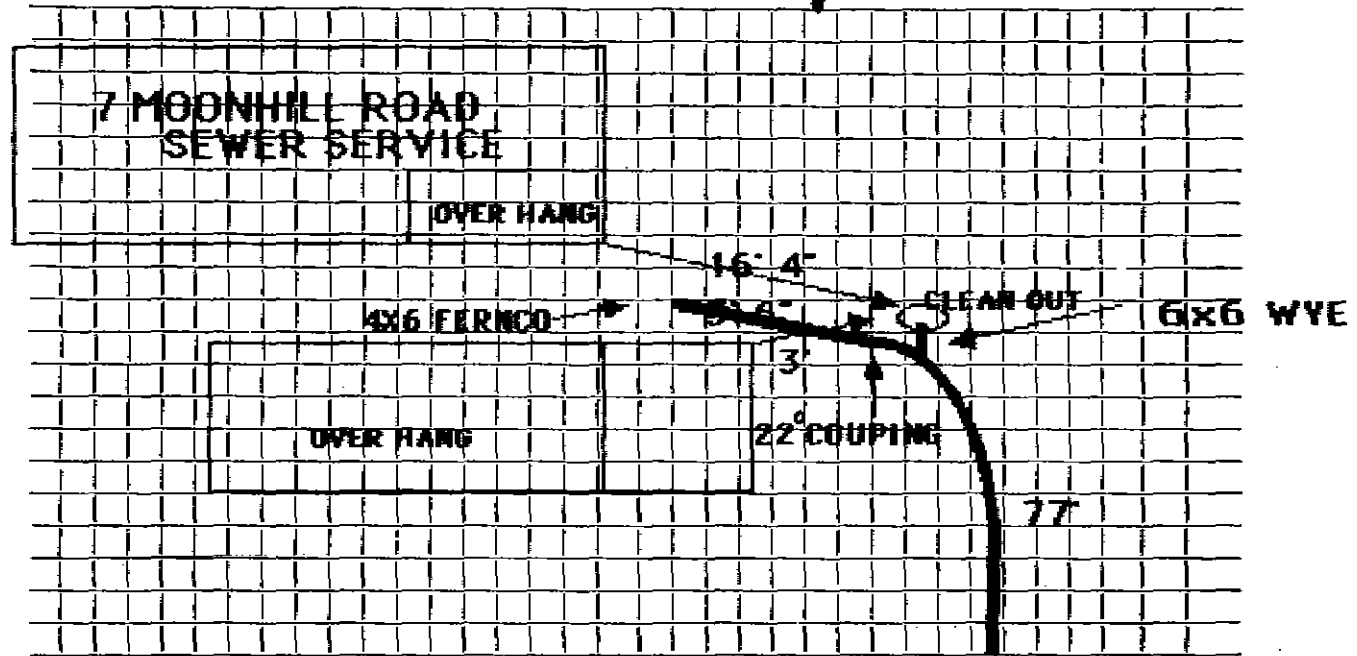

Connection made in ..... Street. Work completed .....

Remarks: .....  
.....  
.....