

Name

Service No.

Miss Bath Hse 1/2 Moonhill Road

Location

Kind of Pipe A.C.

Size 6"

Size of Main 8"

Repair—Renewal—New Service


Location

Date	Material	Amount	Total	Date	Amount
9-14-98	17' 6" A.C.P.	\$ 19.00	\$ 323.00	9-14-78	
				17' 6" Transit	

DATE _____

TOWN OF LEXINGTON — BOARD OF PUBLIC WORKS
SEWER DIVISION

Sketch of Service Here

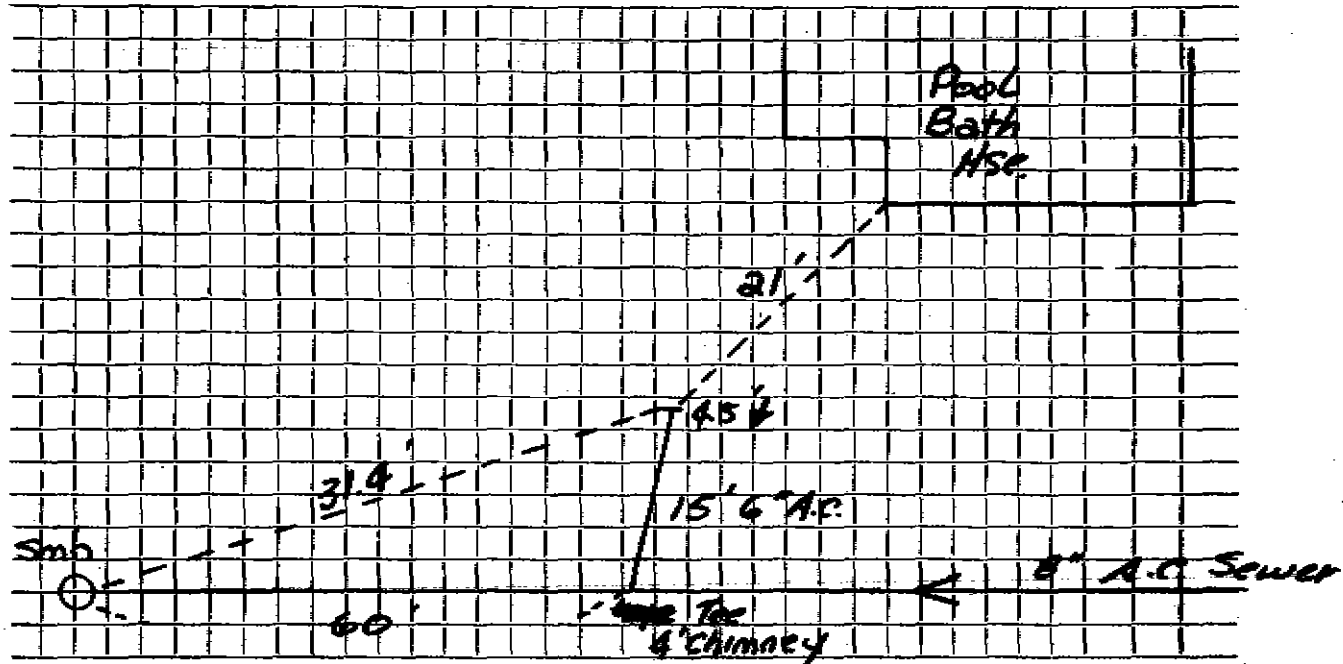

Connection made in Street. Work completed

Remarks:

.....

.....