

Name

Contractor: SSAS Development

Service No.

Address

32 Moonhill Rd

Location

Kind of Pipe

SDR 35 PVC

Size

6"

Size of Main

Repair—Renewal—New Service


Location

Date	Material	Amount	Total	Date	Amount
11/17/18	Ferra to exist stub				
	6" PVC				
	6" tee wye				
	6" cleanout				
	6" tee wye				
	6" PVC				
	45° bend				
	6" PVC				
	22° bend				
	6" PVC				
	6" cleanout				

DATE 12/17/18

TOWN OF LEXINGTON — BOARD OF PUBLIC WORKS
SEWER DIVISION

Sketch of Service Here

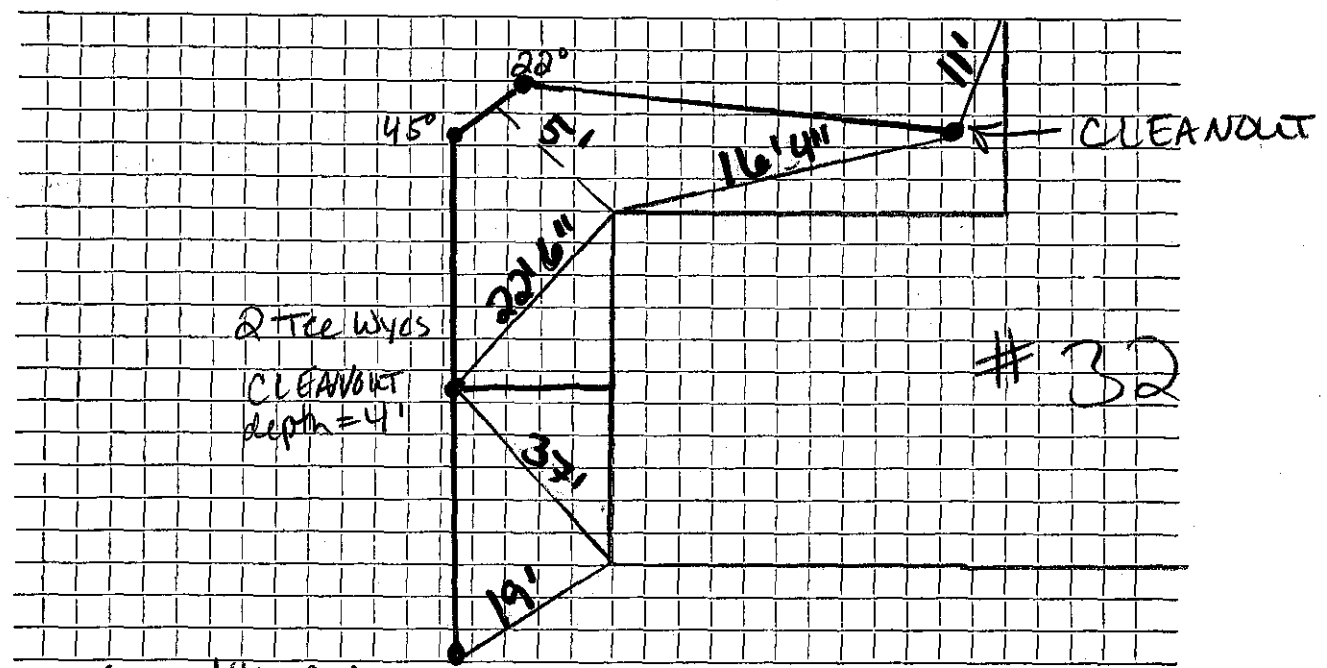

Connection made in Moon Hill Rd Street. Work completed

Remarks: 2 connections to house
2 cleanouts
Tee wyes w/ sweep
Septic Abandonment