


DATE MAY 12, 1997

TOWN OF LEXINGTON — BOARD OF PUBLIC WORKS
SEWER DIVISION

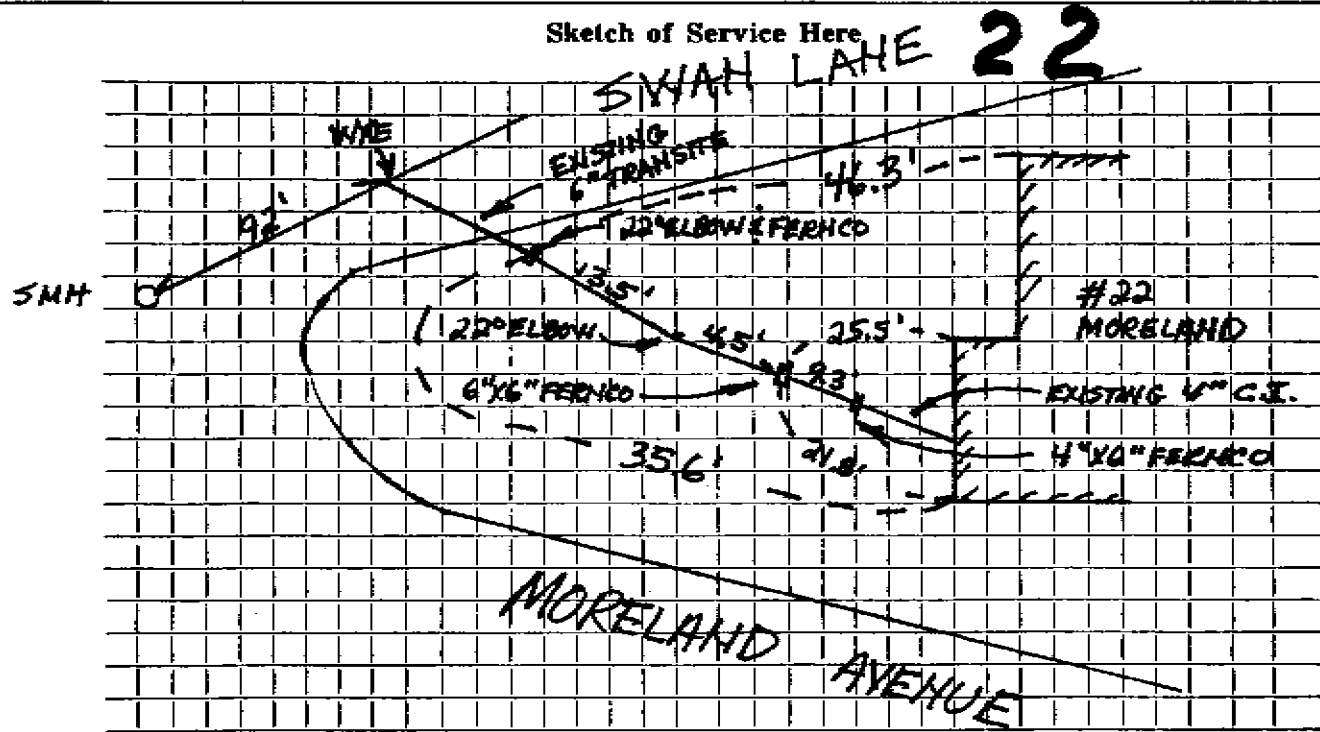

Connection made in SWAN LAKE Street. Work completed

Remarks: OLD CESS POOL CRUSHED AND FILLED