

Name

Service No.

Account # 23 Marchwood Ave

Location

Kind of Pipe A.C.

Size 6"

Size of Main 8"

Repair—Removal—New Service

Location

Date	Material	Amount	Total	Date	Amount
11-3-78	17' 6" S.C.P.	\$19.00	\$323.00	11-3-78	
				17'	6" TRANSITE
					6" X 8" Wye


DATE _____

TOWN OF LEXINGTON — BOARD OF PUBLIC WORKS

SEWER DIVISION

Sketch of Service Here

23

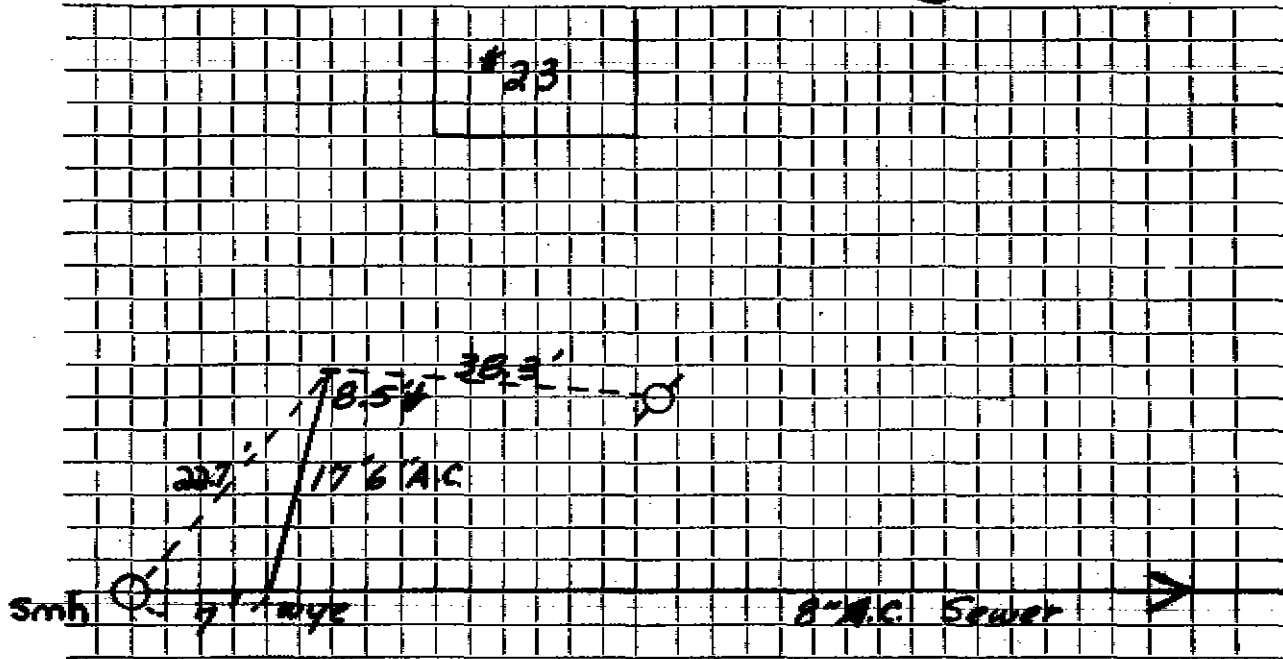

Connection made in Street. Work completed

Remarks:

.....

.....