


DATE _____

TOWN OF LEXINGTON — BOARD OF PUBLIC WORKS

SEWER DIVISION

Sketch of Service Here **27**

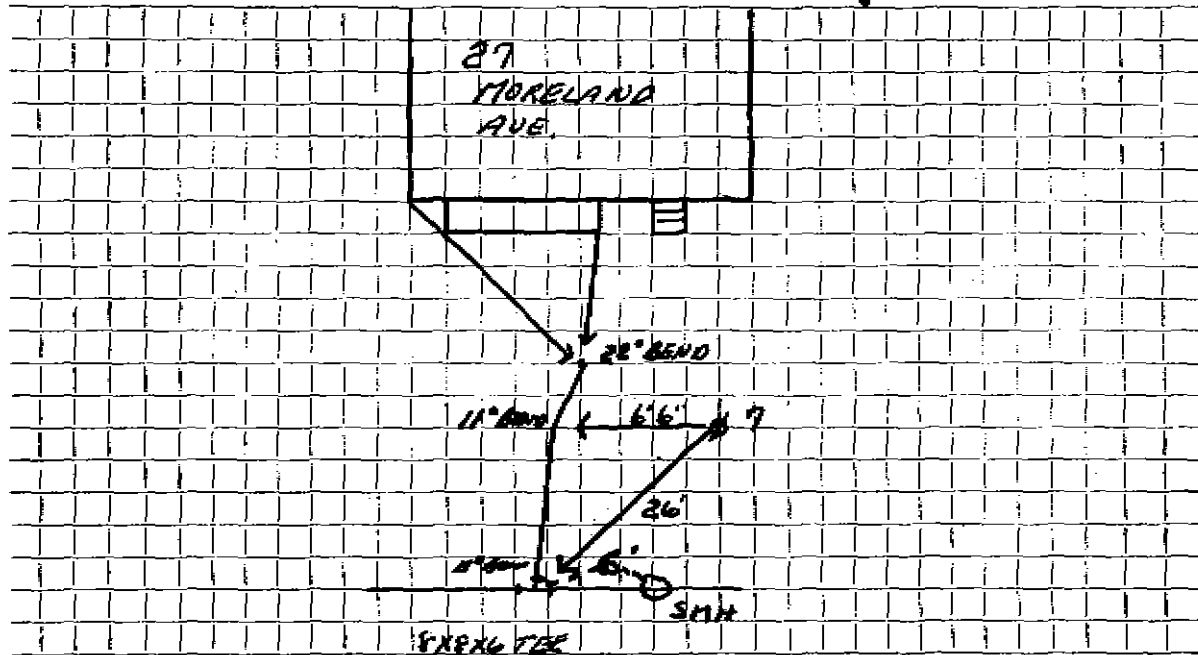

Connection made in
2 8 AC - DIC PERMANENT Street. Work completed

Remarks:
.....