

Name **Bernard Maloney**

Service No. ~~105~~ 241

Address **28 Moreland Avenue**

Lot 37

Location

Kind of Pipe

DeFlaca Bros.

Size **6"**

Size of Main **8"**

~~Existing Sewer~~ **New Service** Permit #A 125


Location **MAR 14 1966**

Date	Material	Amount	Total	Date	Amount	
60	Labor	42.05		11-22-65	Deposit	71.05
	10% O.H.	4.21	46.26			
40'	6" Transite pipe		7.00	8-29-60		
	4 6" 90° Transite Elbow		5.29	10' 6" Transite		
	1 hr. Town Shovel @6.50		6.50	1 6"-90° Elbow		
	1 hr. Trucking @3.00		3.00			
	1 hr. Allis Chalmers @3.00		3.00			
			71.05			
65	23' 6" Transite pipe					

DATE _____

TOWN OF LEXINGTON — BOARD OF PUBLIC WORKS
SEWER DIVISION

Sketch of Service Here **28**

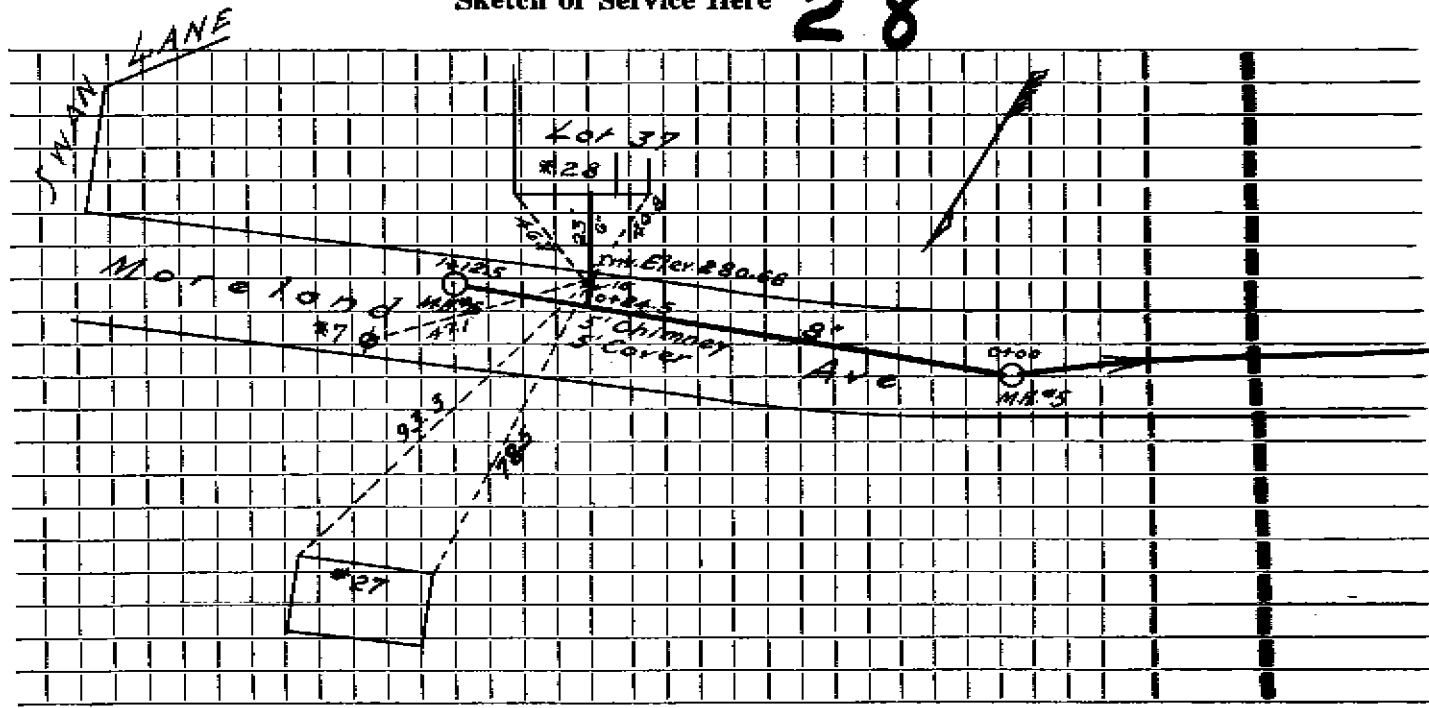

Connection made in Street. Work completed

Remarks:
.....
.....