


MASSACHUSETTS

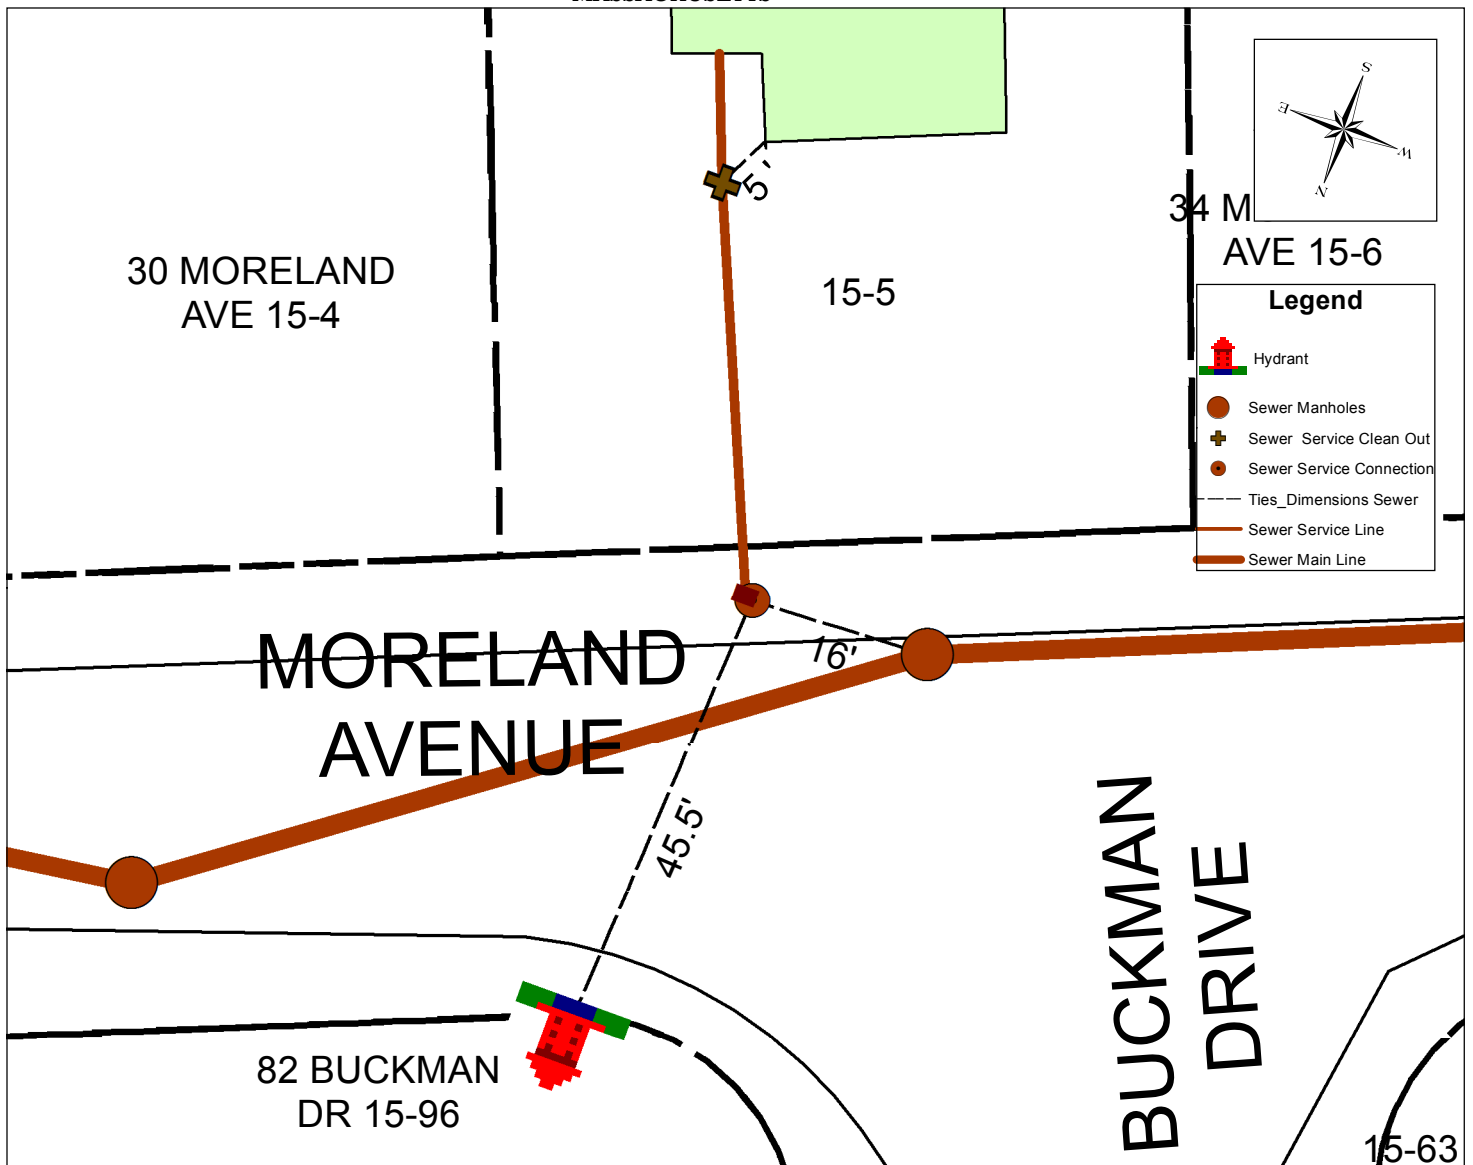

Address	Map and Lot	Permit Number	Contractor Name	Inspector
32 Moreland St	15-5	5837	Iovino Excavating	msprague
Date	Material	Depth of Cover	Amount	
10/1/2014	6x6 AC to PVC Fern Co 6" PVC Pipe - SDR 35 6" PVC Clean Out	6 ft	1-Connect to existing stub ft to Clean Out 1	
	4" PVC Pipe - SDR 35	6 ft	12 ft to HSE	
Type of work completed				

New 6" PVC sewer service installed to new house, connection to existing stub.