

Name

Now BUCKMAN DRIVE

Service No.

Address #33 Moreland Ave

Location Lot 11

Kind of Pipe

Size 6"

Size of Main 8"

~~REPAIR~~ — New Service


Location

Date		Material	Amount		Total		Date		Amount
6-60		Labor	79	35					
		10% O.H.	<u>7</u>	<u>94</u>	87	29			
<del>30</del>		<del>6" Transite pipe</del>			21	00	8-26-60		
<del>1</del>		<del>22 1/2" Transite Bend</del>			5	10	30'	6" Transite	
3		Hrs Town Shovel @6.50			19	50	1	6"-22 1/2" Bend	
1		Hr Allis Chalmers			3	00			
1		Hr Trucking			<u>3</u>	<u>00</u>			
		Bill when connected			138	89			

DATE \_\_\_\_\_

TOWN OF LEXINGTON — BOARD OF PUBLIC WORKS  
SEWER DIVISION

Sketch of Service Here

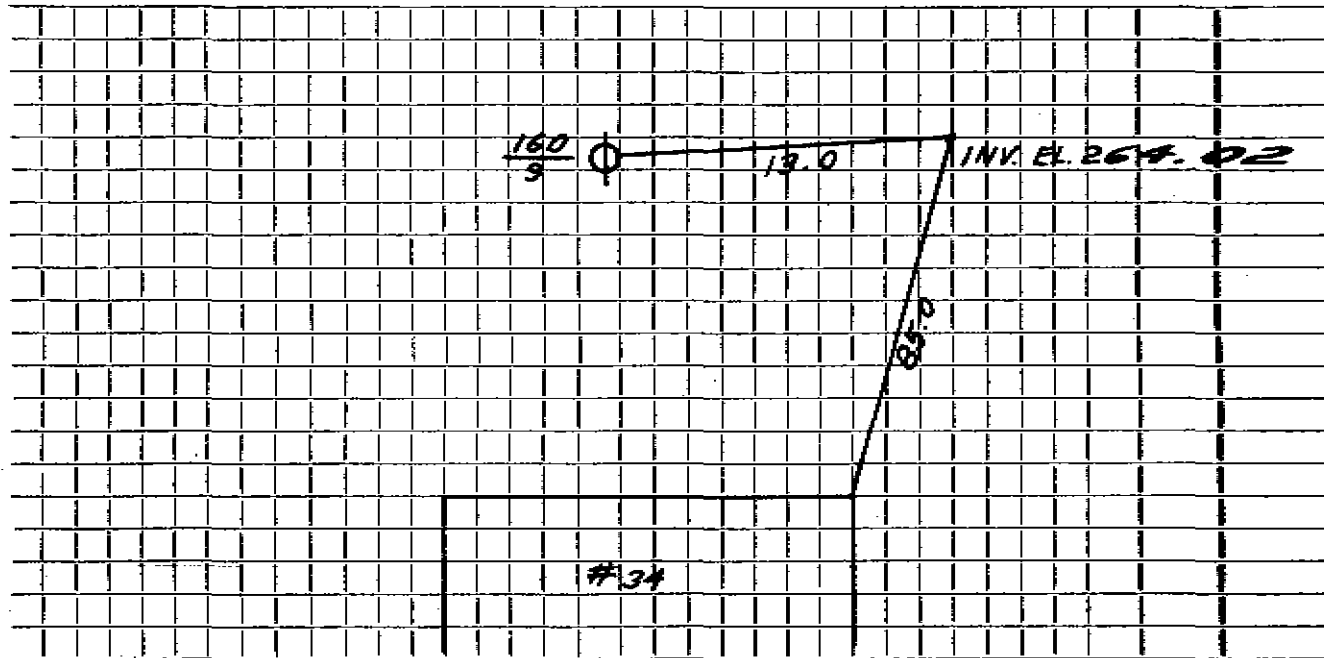

Connection made in ..... Street. Work completed .....

Remarks: .....  
.....  
.....