

Name

Service No.

Address

35A Moseland Ave.

Location

Kind of Pipe

Size 6"

Size of Main 8"

Repair—Renewal—New Service


Location

Date	Material	Amount	Total	Date	Amount
8-65					
30'	6" TRANSITE			9-10-65	
				24'	6" TRANSITE
				1	6" X 8" Wye

DATE _____

TOWN OF LEXINGTON — BOARD OF PUBLIC WORKS
SEWER DIVISION

Sketch of Service Here **35A**

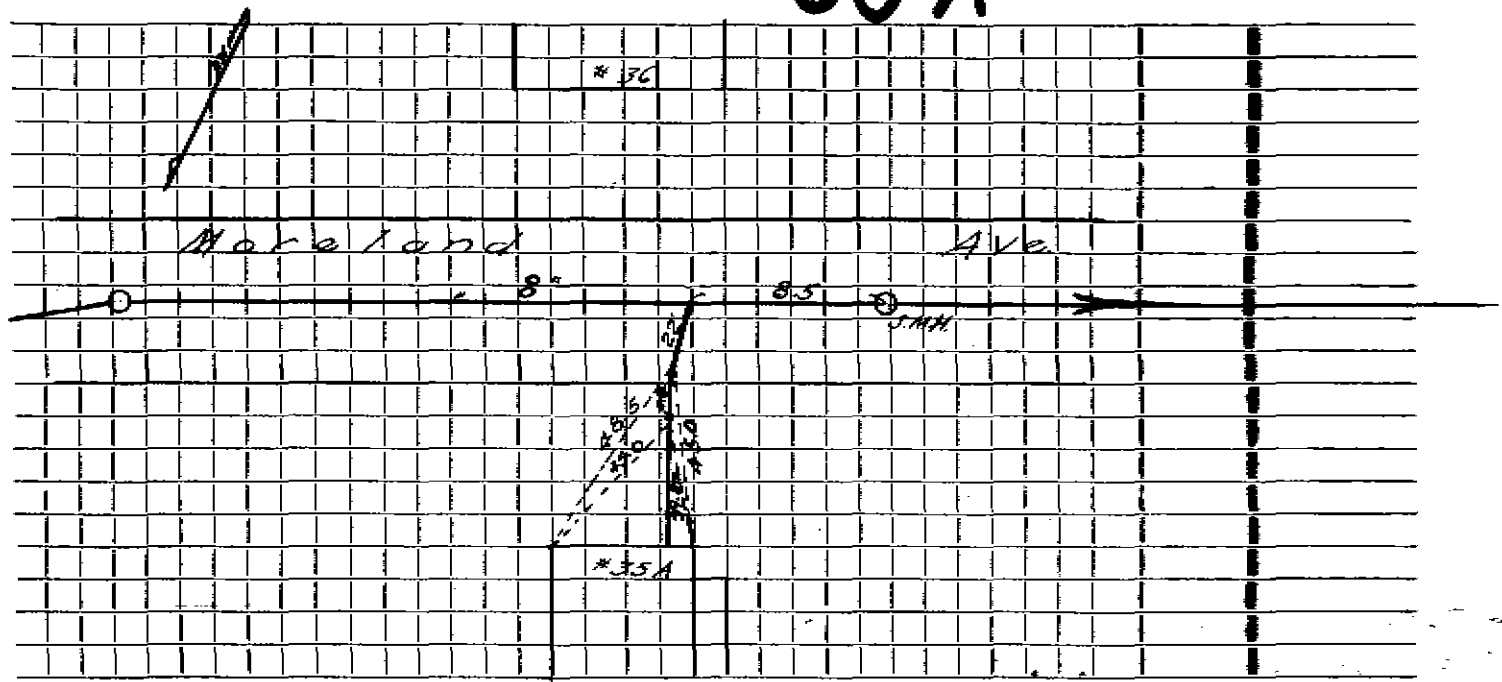

Connection made in Street. Work completed

Remarks: Original Service 8-23-60