

Name

Service No.

Address 37 Moreland Ave

Lot 14

Location

Kind of Pipe PVC

Size 6"

Size of Main 8"

Repair—Renewal—New Service ~~Teardown~~ Rev. Mciver

Location


Date	Material	Amount	Total	Date	Amount
8/2005	4" PVC				
	4" Clean out				
	4" 45° bend + Ferrico				
	4" Sweep 22°				
1	4x6 Ferrico				
52	6" PVC				
	6" AC X PVC Ferrico				
8/23/60	1 8"x6" Wye				
	1 6" Elbow				
26'	6" AC Pipe				

DATE \_\_\_\_\_

TOWN OF LEXINGTON — BOARD OF PUBLIC WORKS

SEWER DIVISION

Sketch of Service Here

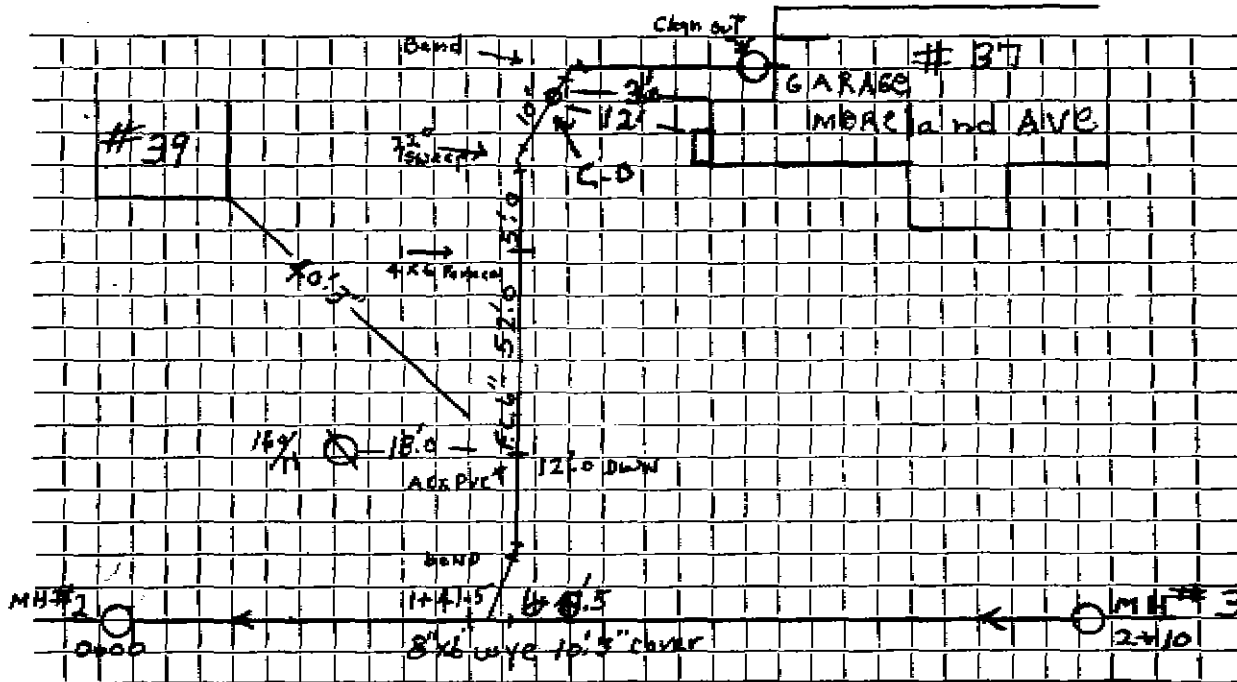

Connection made in Moreland Ave 1960 Street.

Work completed Feardown = 08/2005

Remarks: ..... K. M. J. J. J. J.