

Name **Marion Runstein**

Service No. **173**

Address **39 Moreland Avenue**

Location

Kind of Pipe **Permit #A17**

Size

Size of Main

~~Business~~ **New Service Valeri Const. Co.**

Location

DEC 31 1966


Date	Material	Amount	Total	Date	Amount
69	Labor 32.52			9-27-66	Deposit 92.69
60	" 9.38	46.90			
	10% O.H.	4.69	51.59		
	20' 6" Transite pipe		14.00		
	1 11 1/2" Transite Bend		5.10		
	2 hrs. Town Shovel @6.50		13.00		
	1 hr. Allis Chalmers		3.00		
	2 hrs. Trucking		6.00		
	Bill When Connected		92.69		
65	36' 6" Transite Pipe				

DATE _____

TOWN OF LEXINGTON — BOARD OF PUBLIC WORKS
SEWER DIVISION

Sketch of Service Here

39

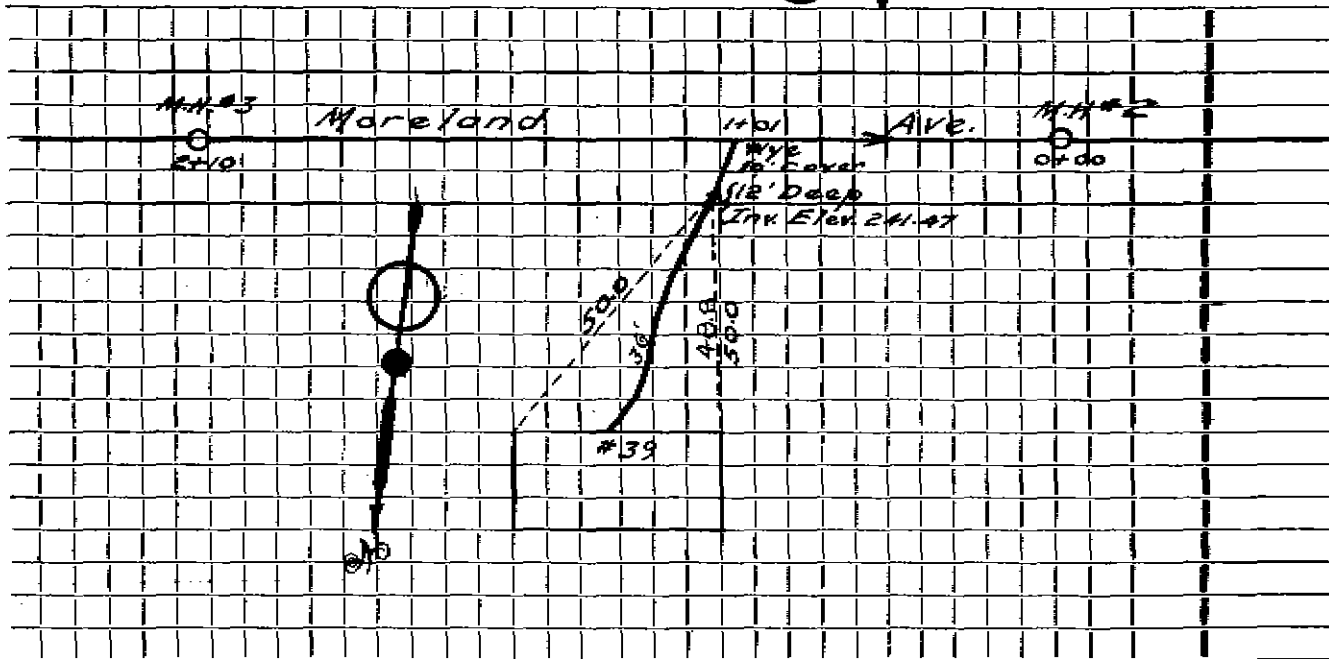

Connection made in Street. Work completed

Remarks:
.....
.....