

Name **Harry Trask**

Service No. **93**

Address **42 Moreland Avenue**

**Lot #9**

Location

Kind of Pipe

Size

Size of Main

Repair—Renewal—New Service **Valeri #1201**

Location

**JAN 27 1969**


Date	Material	Amount	Total	Date	Amount
0	Labor	12.52		10-1-68	35.15
	10% O.H.	1.25	13.77		
	10' 6" Transite pipe		7.00		
	1 6" Clay Elbow		1.88		
	1 hr. Town Shovel @6.50		6.50		
	1 hr. Allis Chalmers @3.00		3.00		
	1 hr. Trucking @3.00		3.00		
			35.15		
-68	38' 6" Transite pipe				
	7' 4" Cast Iron pipe				

DATE \_\_\_\_\_

TOWN OF LEXINGTON — BOARD OF PUBLIC WORKS

SEWER DIVISION

Sketch of Service Here **42**

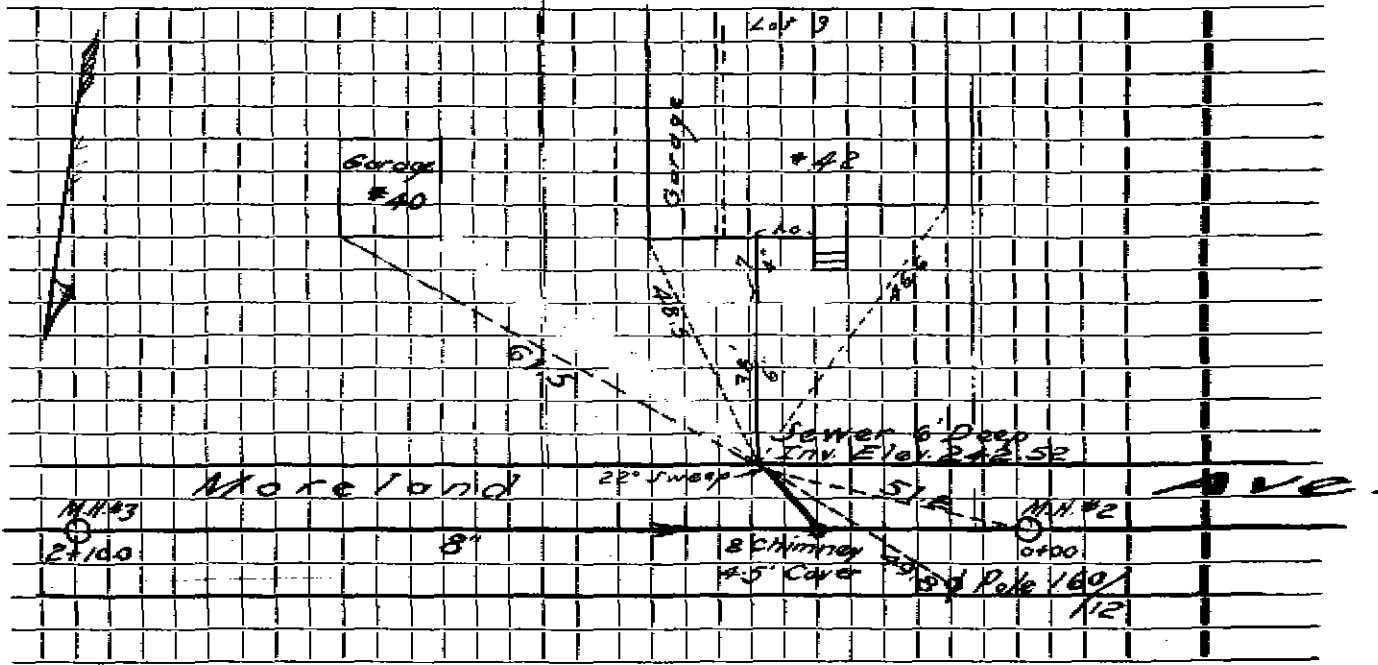

Connection made in ..... Street. Work completed .....

Remarks: .....  
.....  
.....