

Name

Service No.

Address

9 Morse Land Ave.

Location

Kind of Pipe

Size 6"

Size of Main 8"

Repair—~~Remove~~ New Service

Location

Date

Material

Amount

Total

Date

Amount

8-19-60

10' 6" TRANSITE


1 6" CLAY ELBOW

DATE \_\_\_\_\_

# TOWN OF LEXINGTON — BOARD OF PUBLIC WORKS

## SEWER DIVISION

Sketch of Service Here

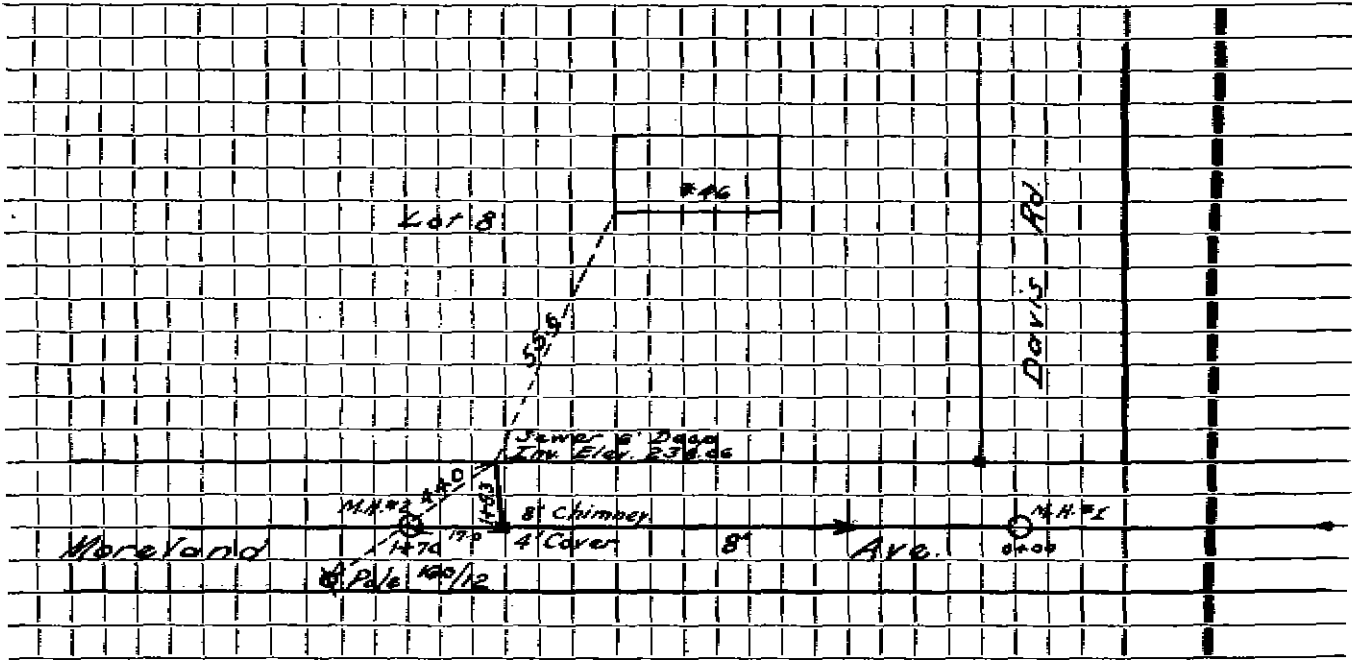

Connection made in ..... Street. Work completed .....

Remarks: .....

.....

.....