

Name **Arthur Bienenstock**

Service No. 169

Address **45 Moreland Avenue**

Location

Kind of Pipe **Permit #A5**

Size

Size of Main

~~Permit #A5~~ **New Service Valeri Const. Co.**

Location

**DEC 31 1965**

Date	Material	Amount	Total	Date	Amount
-60	Labor	51.44		9-24-65	130.78
-60	"	25.97	77.41		
	10% O.H.	7.74	85.15	8-15-60	
	<del>20' 6" Transite pipe</del>		14.00		20' 6" Transite
	<del>1 22 1/2° Transite Elbow</del>		2.24		1 6"-22 1/2° Elbow
	<del>1 11 1/4° Transite Bend</del>		5.10		1 6"-11 1/4° Bend
	<del>1 6" Transite Elbow 90°</del>		5.29		1 6"-90° Elbow
	2 hrs. Town Shovel		13.00		1 6" X 8" Wye
	1 hr. Trucking @3.00		3.00		
	1 hr. Trojan Loader @3.00		3.00		
	<b>BILL WHEN CONNECTED</b>		130.78		
1-65	35' 6" Transite pipe				

Name **Arthur Bienenstock**

Service No. 169

Address **45 Moreland Avenue**

Location

Kind of Pipe **Permit #A5**

Size

Size of Main

~~Service~~ **New Service Valeri Const. Co.**

Location

**DEC 31 1965**

Date	Material	Amount	Total	Date	Amount
-60	Labor	51.44		9-24-65	130.78
-60	"	25.97	77.41		
	10% O.H.	7.74	85.15	8-15-60	
	<del>20' 6" Transite pipe</del>		14.00	20' 6" Transite	
	<del>1 22 1/2° Transite Elbow</del>		2.24	1 6"-22 1/2° Elbow	
	<del>1 11 1/4° Transite Bend</del>		5.10	1 6"-11 1/4° Bend	
	<del>1 6" Transite Elbow 90°</del>		5.29	1 6"-90° Elbow	
	2 hrs. Town Shovel		13.00	1 6" X 8" Wye	
	1 hr. Trucking @3.00		3.00		
	1 hr. Trojan Loader @3.00		3.00		
	<b>BILL WHEN CONNECTED</b>		130.78		
-65	35' 6" Transite pipe				


DATE \_\_\_\_\_

TOWN OF LEXINGTON — BOARD OF PUBLIC WORKS

SEWER DIVISION

Sketch of Service Here

**45**

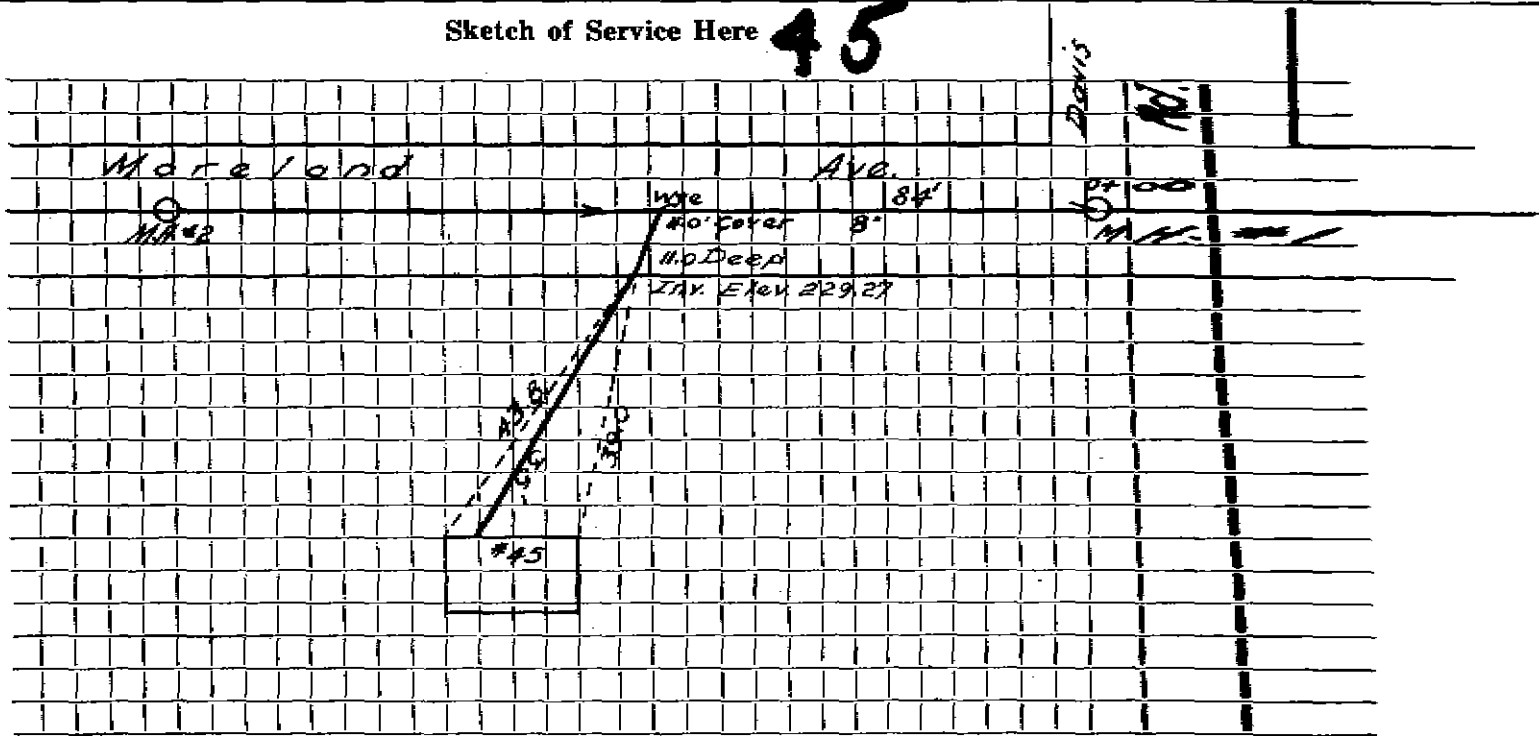

Connection made in ..... Street. Work completed .....

Remarks: .....


.....

.....

DATE \_\_\_\_\_

TOWN OF LEXINGTON — BOARD OF PUBLIC WORKS  
SEWER DIVISION

Sketch of Service Here **45**

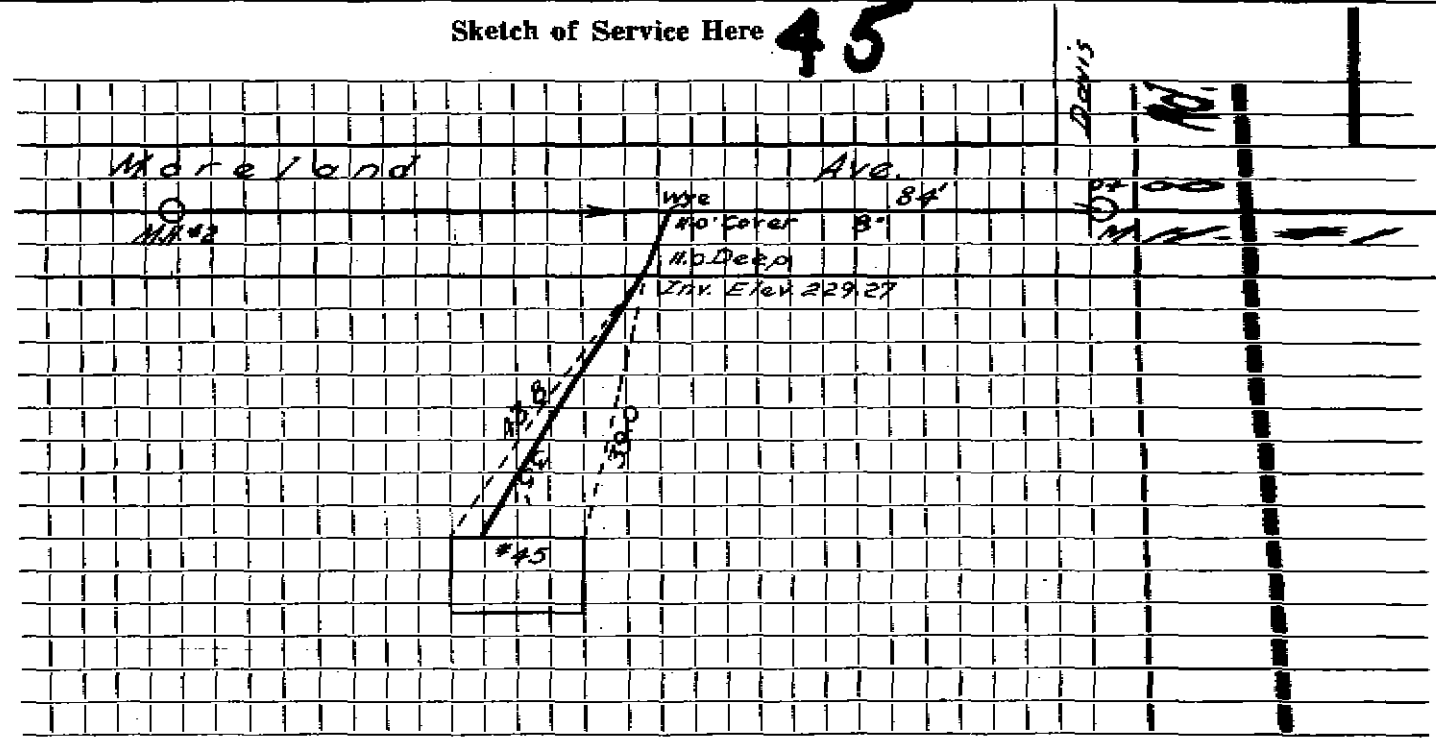

Connection made in ..... Street. Work completed .....

Remarks: .....  
.....  
.....