

Name Yuan-Shion Tung

Service No. 24

Address # 6 MORELAND AVE

Location

Kind of Pipe ACP & PVC

Size 6"

Size of Main 8" ACP


~~Repair~~ ~~Renewal~~ New Service Valeri #3881

Location SEP 17 1984

Date	Material	Amount	Total	Date		Amount
<del>H-20</del> <del>78</del>	<del>12' 6" ACP @</del>	<del>\$19.00</del>	<del>\$228.00</del>	<del>7-15-78</del>	Deposit	<del>228.00</del>
7/26/84	62' x 6" PVC					
1	6" x 45° Elbow			11-20-78		
2	6" x 22½° Elbow				12' 6" Transite	
1	6" PVC x ACP Adaptor				1 6" x 8" Wye	
800	Red Sewer Brick					
1	14" Frame & Cover					

DATE Nov 20, 1978

TOWN OF LEXINGTON — BOARD OF PUBLIC WORKS  
SEWER DIVISION

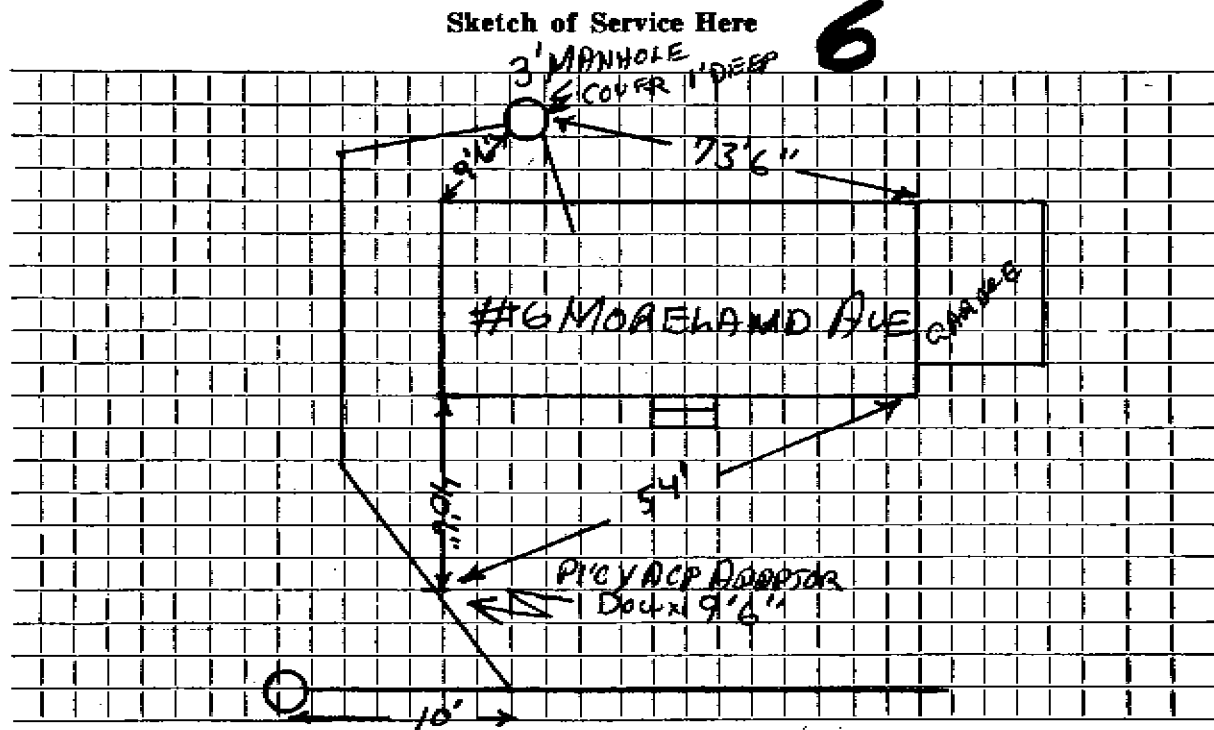

Connection made in MORELAND AVE Street.

Work completed AUGUST 10, 1984

Remarks: .....

.....

.....