




DATE 11/30/2019

TOWN OF LEXINGTON — BOARD OF PUBLIC WORKS  
SEWER DIVISION

Sketch of Service Here

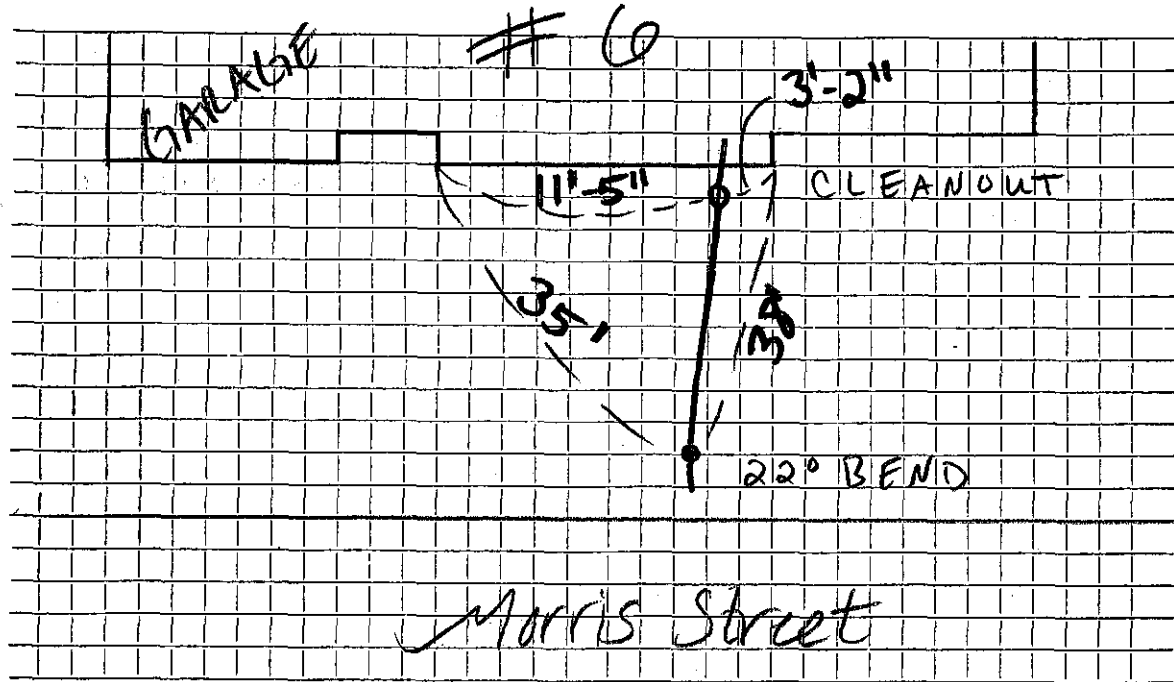

Connection made in ... Morris Street. Work completed .....

Remarks: 22° Bend FernCo connection to existing stub