


DATE 10-12-01

TOWN OF LEXINGTON — BOARD OF PUBLIC WORKS
SEWER DIVISION

Sketch of Service Here

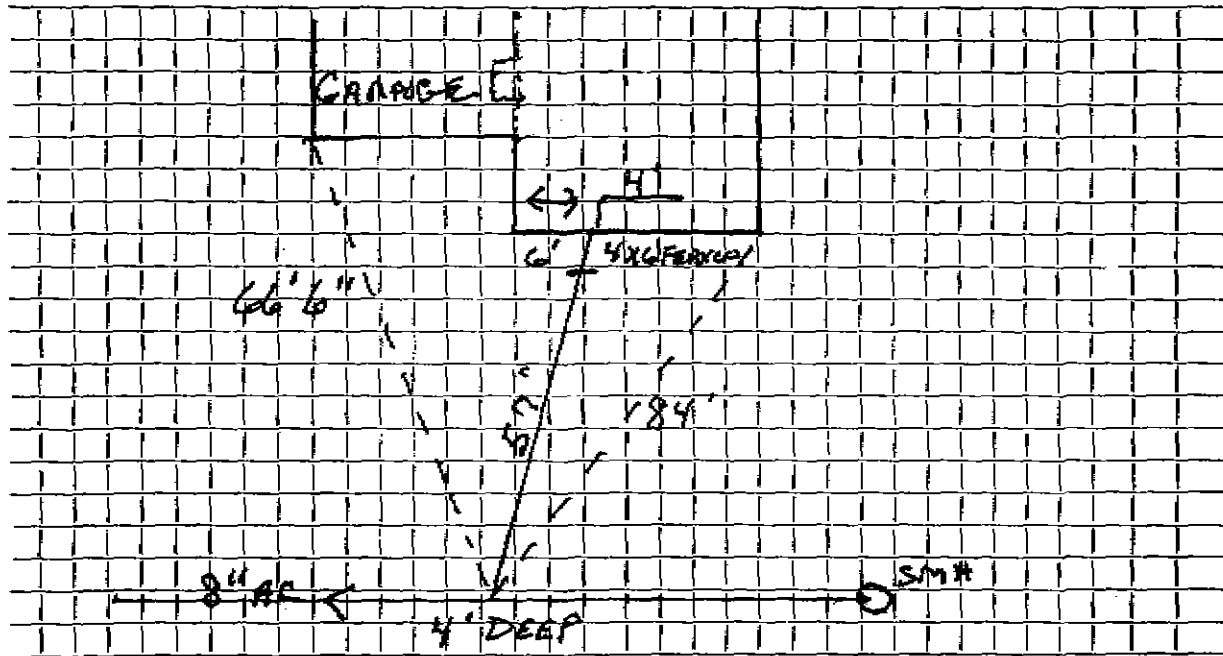

Connection made in MARRIS Street. Work completed

Remarks: INSTALLED BY J. McLAUGHLIN