

Name William J. Weisensee

Service No.

130 (75)

Address 4 MORRIS ST

41 Morris ST.

Location

Kind of Pipe AC

Size 6"

Size of Main 8"

Repair—Renewal—New Service Russell Sibley #2772

Location AUG 16 1976


Date	Material	Amount	Total	Date	Amount
July 21 76	21' 6" AC	\$ 10 00	\$ 210 00	11-4-5	Deposit 210 00
1/18/75	45' 6" Transite Pipe				
	17' 4" Cast Iron Pipe			7-21-75	
					21' 6" Transite
					1 6" X 8" Wye
				1-22-81	Balance 12' 04'

DATE _____

TOWN OF LEXINGTON — BOARD OF PUBLIC WORKS

SEWER DIVISION

Sketch of Service Here **4**

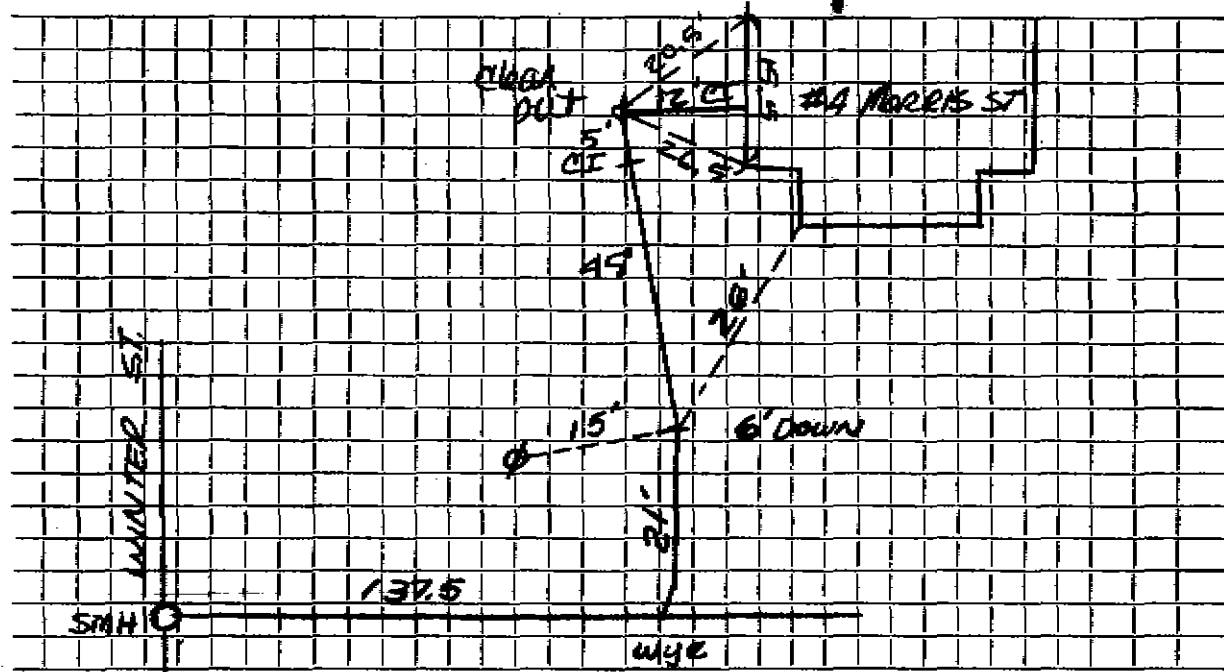

Connection made in MORRIS Street. Work completed 11-18-75

Remarks:

.....

.....