

Name

Service No.

Address 8 MORRIS ST LOT 90-23 (OFF #6 MORRIS) VACANT  
8 MORRIS ST.

Location

Kind of Pipe AC

Size 6"

Size of Main 8"

Repair—Renewal—New Service

Location


Date	Material	Amount	Total	Date	Amount
<del>July 18 75</del>	<del>192600</del>	\$ 10 00	\$ 190 00		
				7-18-75	
				19' 6" TRANSITE	
				1 6" X 8" WYE	

DATE \_\_\_\_\_

TOWN OF LEXINGTON — BOARD OF PUBLIC WORKS  
SEWER DIVISION

Sketch of Service Here

8

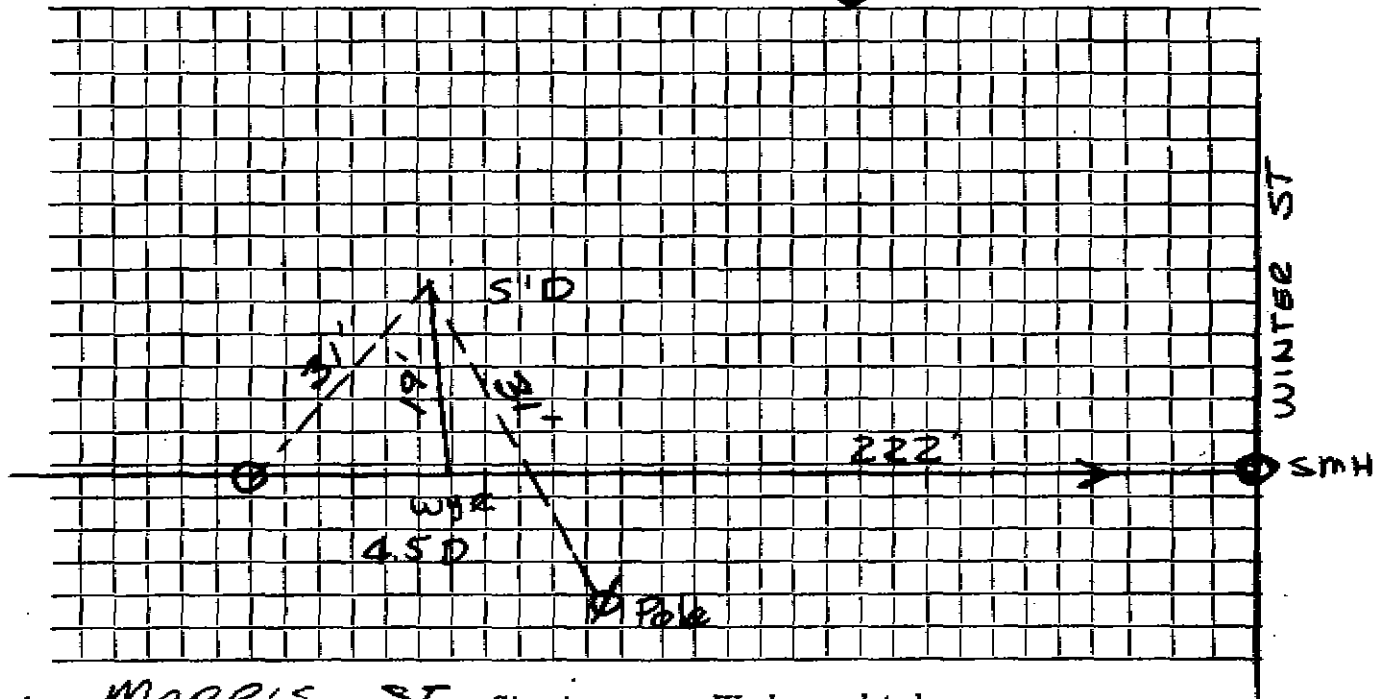

Connection made in MORRIS ST. Street. Work completed .....

Remarks: .....  
.....  
.....