




SEWER DIVISION

Sketch of Service Here

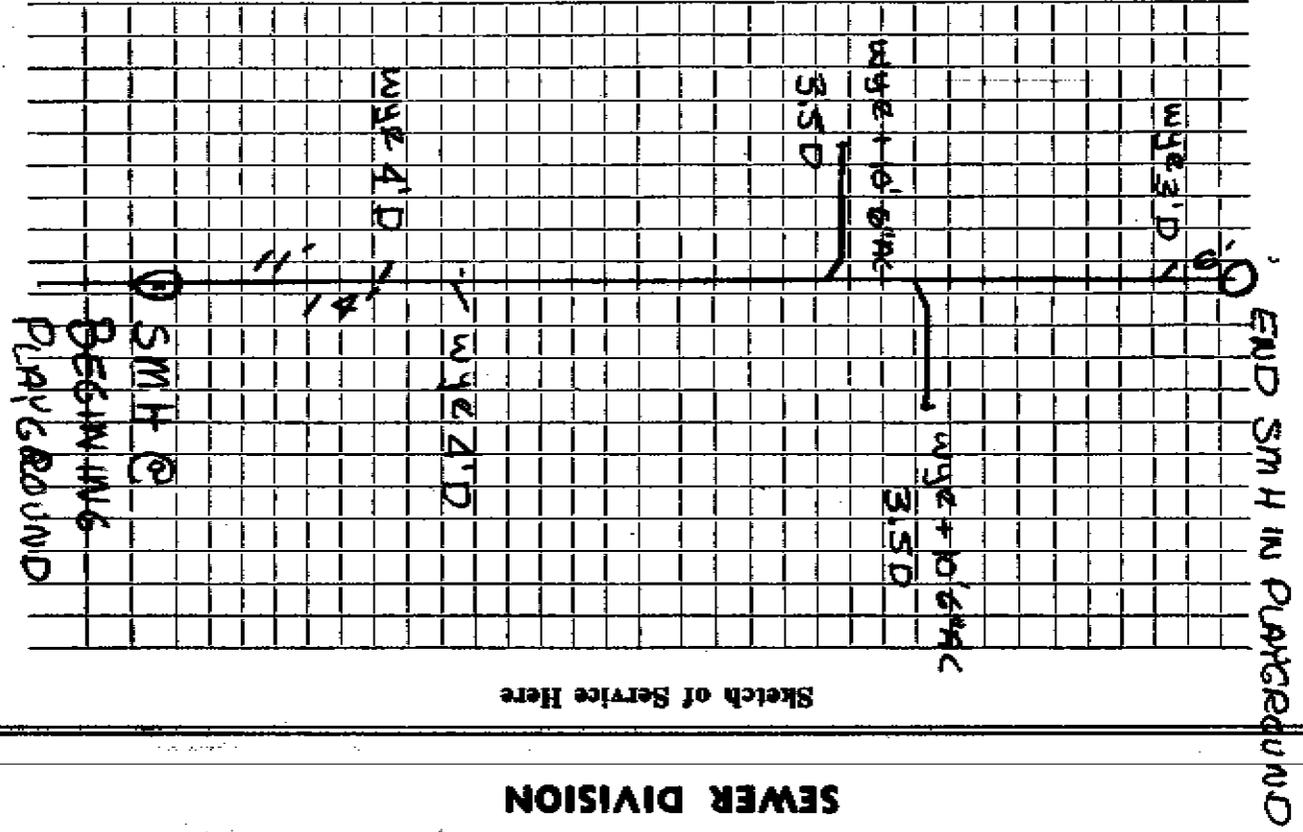

Connection made in *MORRIS ST.* Street.

Work completed

Remarks: