


DATE 12-15-1999

TOWN OF LEXINGTON — BOARD OF PUBLIC WORKS
SEWER DIVISION

Sketch of Service Here

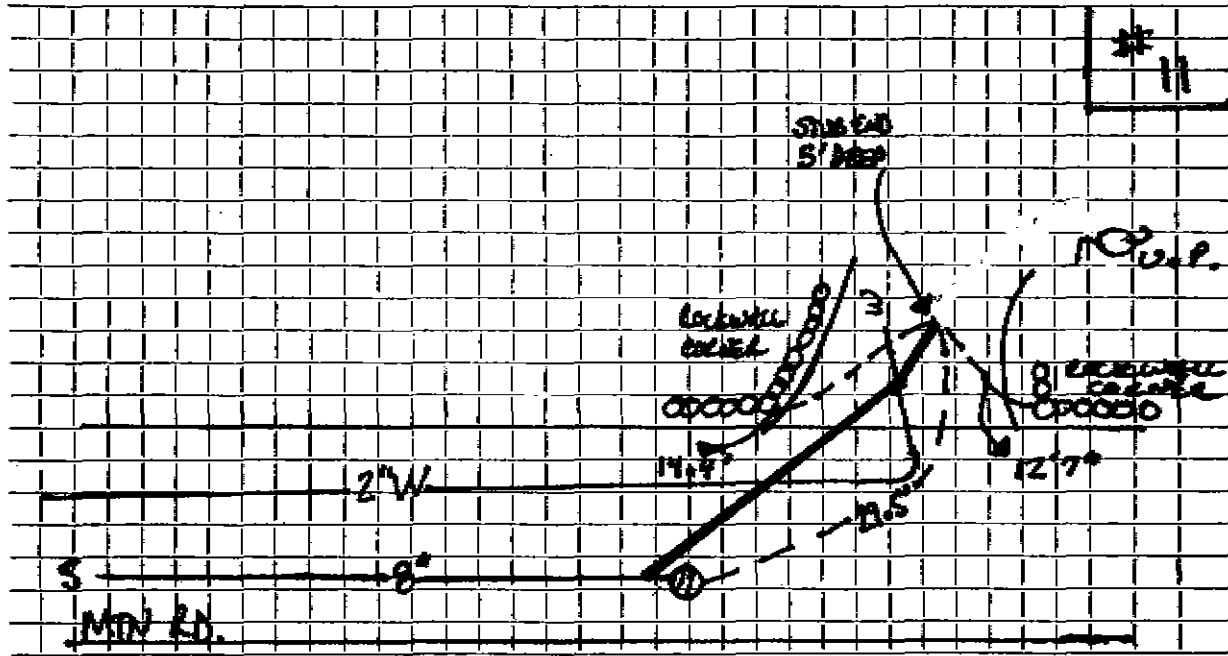

Connection made in Street. Work completed

Remarks: 1" WATER SERVICE IS 6" ABOVE SEWER LATERAL

FIELD BOOK 99-12-2 PG 17

D.V.