




DATE 12-15-1999

TOWN OF LEXINGTON — BOARD OF PUBLIC WORKS  
SEWER DIVISION

Sketch of Service Here

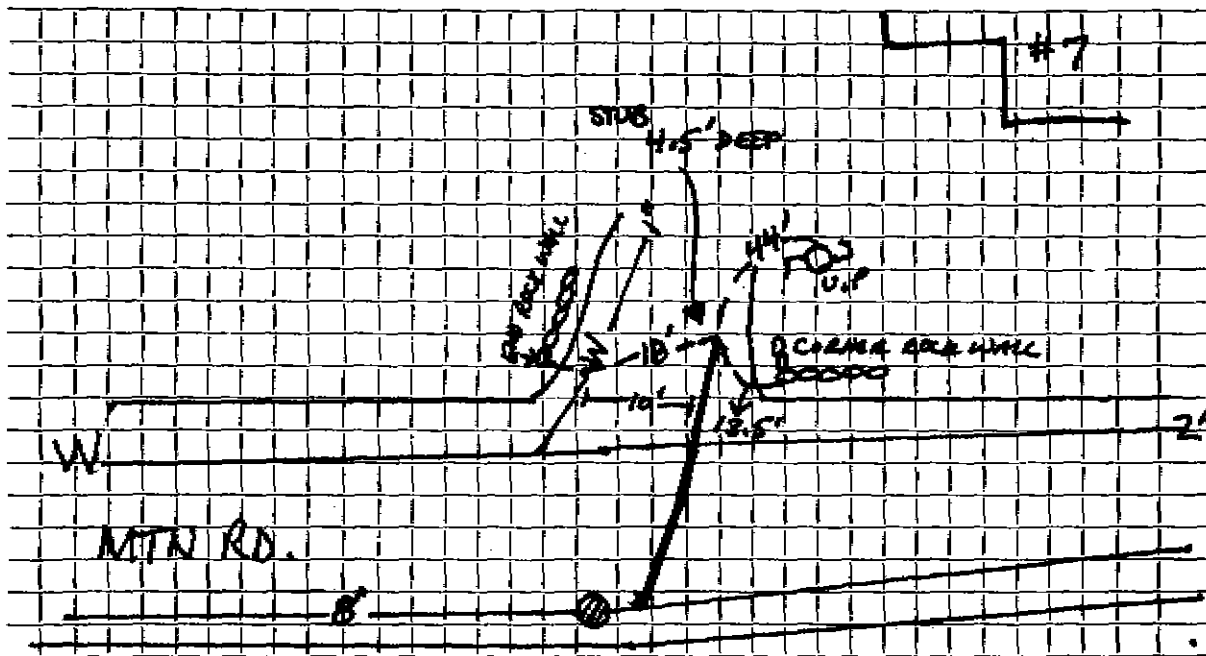

Connection made in ..... Street. Work completed .....

Remarks: 2" WATER MAIN RUNS UNDER SEWER SERVICE 6"

FIELD BOOK 99-12-2 PG 16

D.V.