

Name

Service No.

Address Mountain Rd. (TURNING Mills Hd.)

Location

Kind of Pipe A.C.

Size 6"

Size of Main 6"

Repair—Renewal—New Service


Location

Date	Material	Amount	Total	Date	Amount
4/20/75	A.C. @ 10.00		310.00	4-28-75	
				31' 6" TRANSITE	
				1 6" X 8" WYE	

DATE _____

TOWN OF LEXINGTON — BOARD OF PUBLIC WORKS
SEWER DIVISION

Sketch of Service Here

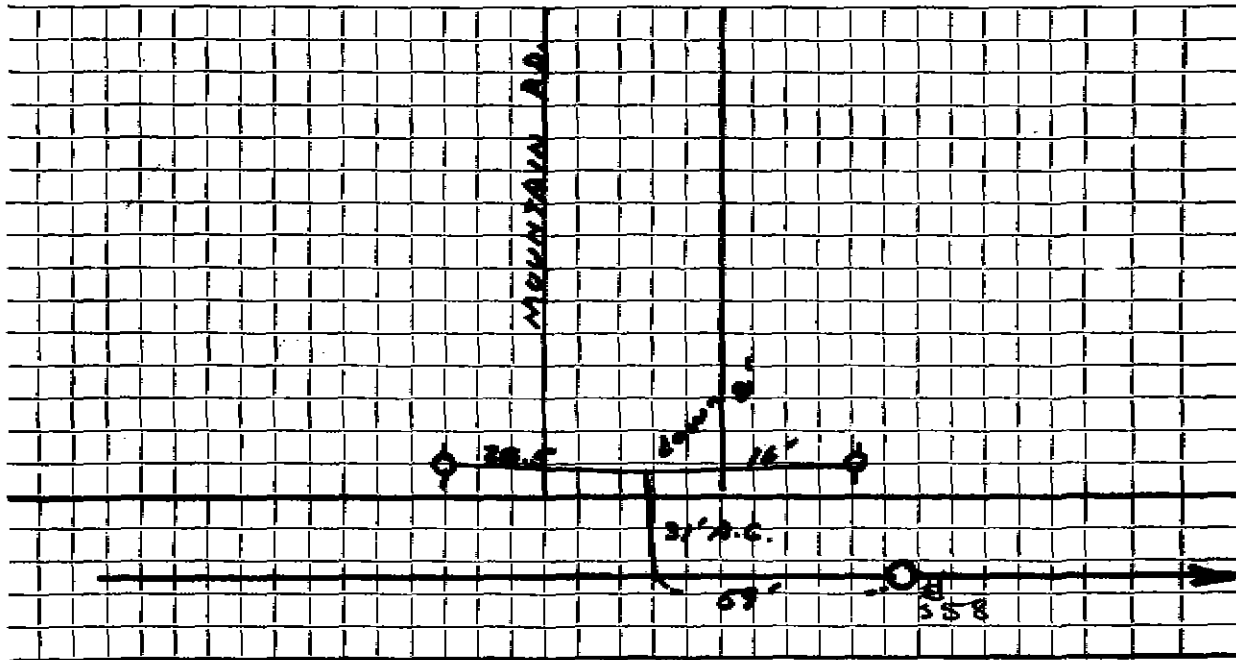

Connection made in Street. Work completed

Remarks:
.....
.....