




DATE 4/2/19

TOWN OF LEXINGTON — BOARD OF PUBLIC WORKS  
SEWER DIVISION

Sketch of Service Here

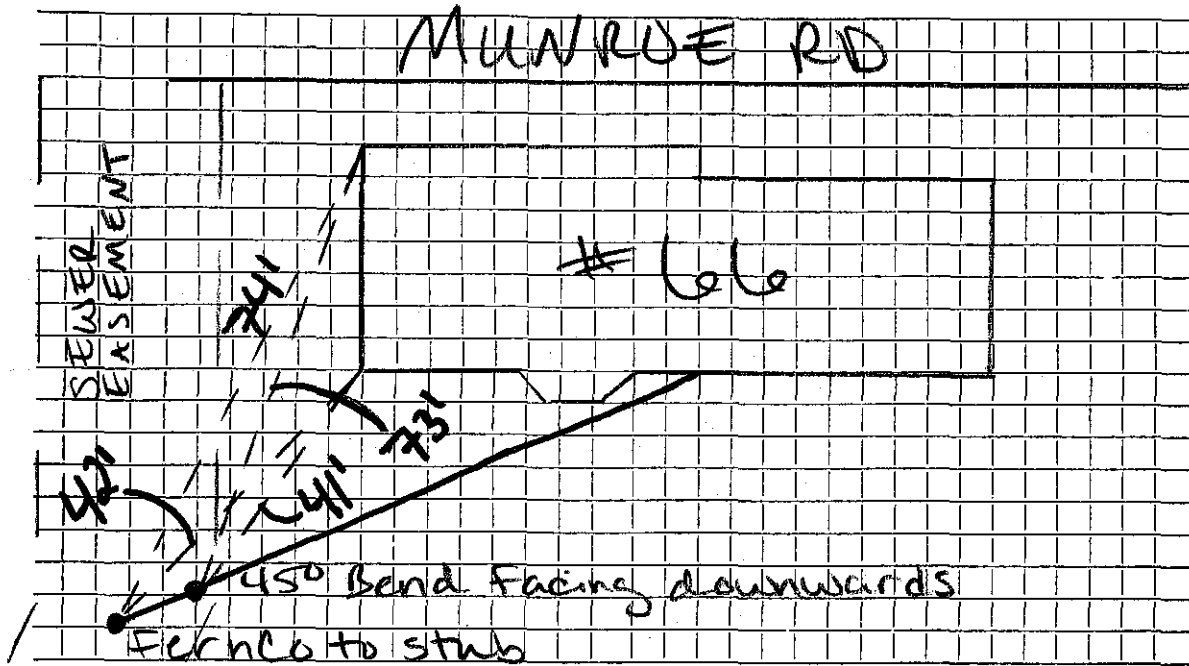

Connection made in Sewer Easements Street. Work completed .....

Remarks: Originally connected to towns drainage system in 2015.  
Repaired and connected to sewer stub in sewer easement.