

Name MOORE HOMES
Address 1 MURKOE RD

Service No.
PERMIT # 1527

Kind of Pipe PVC TO AC

Size 6"

Location

Repair—Renewal—**New Service**


Location HUDSON RD

Date	Material	Amount	Total	Date	OUT SIDE	Amount
	1X SIDE				STUB B.C.	
	38'-6" PVC				6" PVC X 6" AC FEANCO	
	4X 6 PVC FEANCO				2 1/2' - 6" AC	
					1-6" 45° BEND	
					1-6" X 8" WYE	

DATE 6-18-01

TOWN OF LEXINGTON — BOARD OF PUBLIC WORKS

SEWER DIVISION

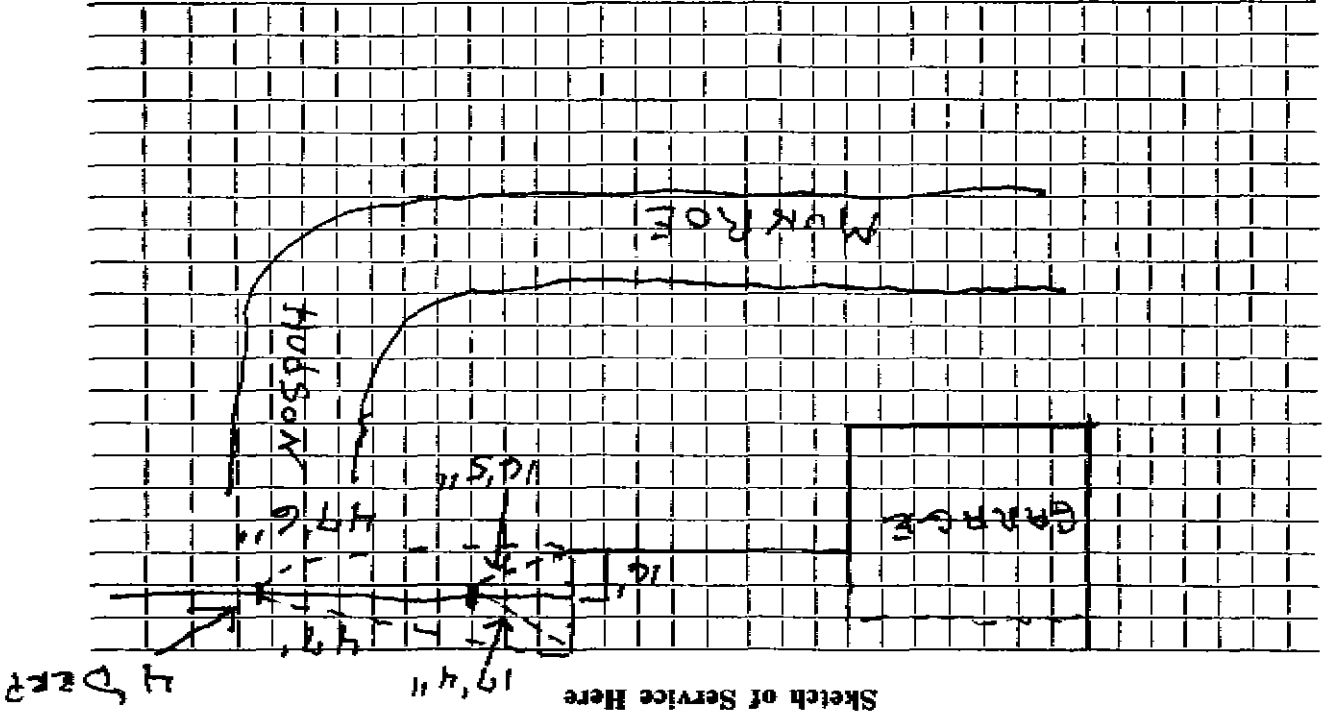

Sketch of Service Here

Work completed

Street

Connection made in HUDSON

Remarks: INSTALLED BY J McLAUGHLIN