


DATE _____

TOWN OF LEXINGTON — BOARD OF PUBLIC WORKS
SEWER DIVISION

Sketch of Service Here

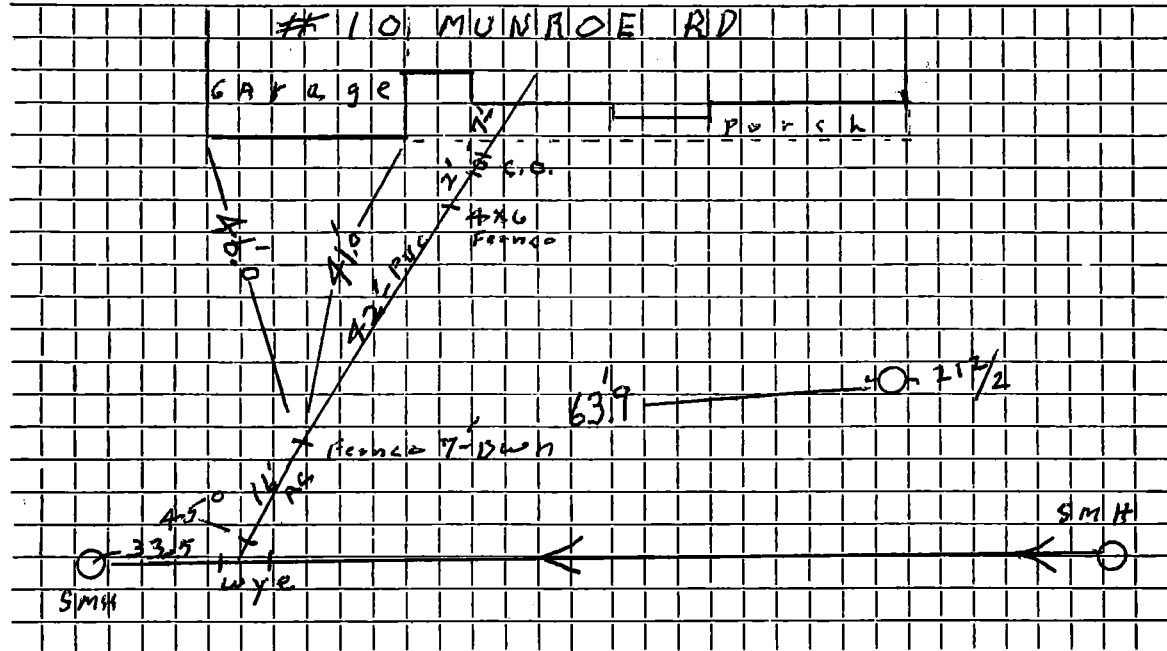

Connection made in Street.

Work completed 12/5/10 J. McLaughlin

Remarks: T.P. Tie off old Tel. Pole Tie card

.....
.....