

Address **4 MURROE RD.**

Location **14 Murroe Road**

Size of Pipe **6"**

Size of Main **8"**

Location **8303**

Location **5-18-64**

New Service


Date	Material	Amount	Total	Date	Amount
6-63	LABOR	83.15		11-12-63	300.00
6-63	"	22.11		5-18-64	22.47
	10% O.H.		115.79		227.53
32'	6" TRANSITE PIPE @ .83	10.53	26.24	14.6-6" TRANSITE	
1	BAG CEMENT		1.53	1 6"-45° BEND	
1	11# TRANSITE ELBOW		2.35	1 6" X 8" WYE	
4	HRS. IRON SHOVEL @ 6.50		26.00		
2	HRS. TRUCKING @ 3.00		6.00		
4	YDS. LOAM @ 3.00		12.00		
	PREP. CHARGE		87.60	14.6 feet 6" A.C.	
			277.53	Installed by contractor	
				\$6.00 per foot	87.60

DATE _____

TOWN OF LEXINGTON — BOARD OF PUBLIC WORKS

SEWER DIVISION

Sketch of Service Here **14**

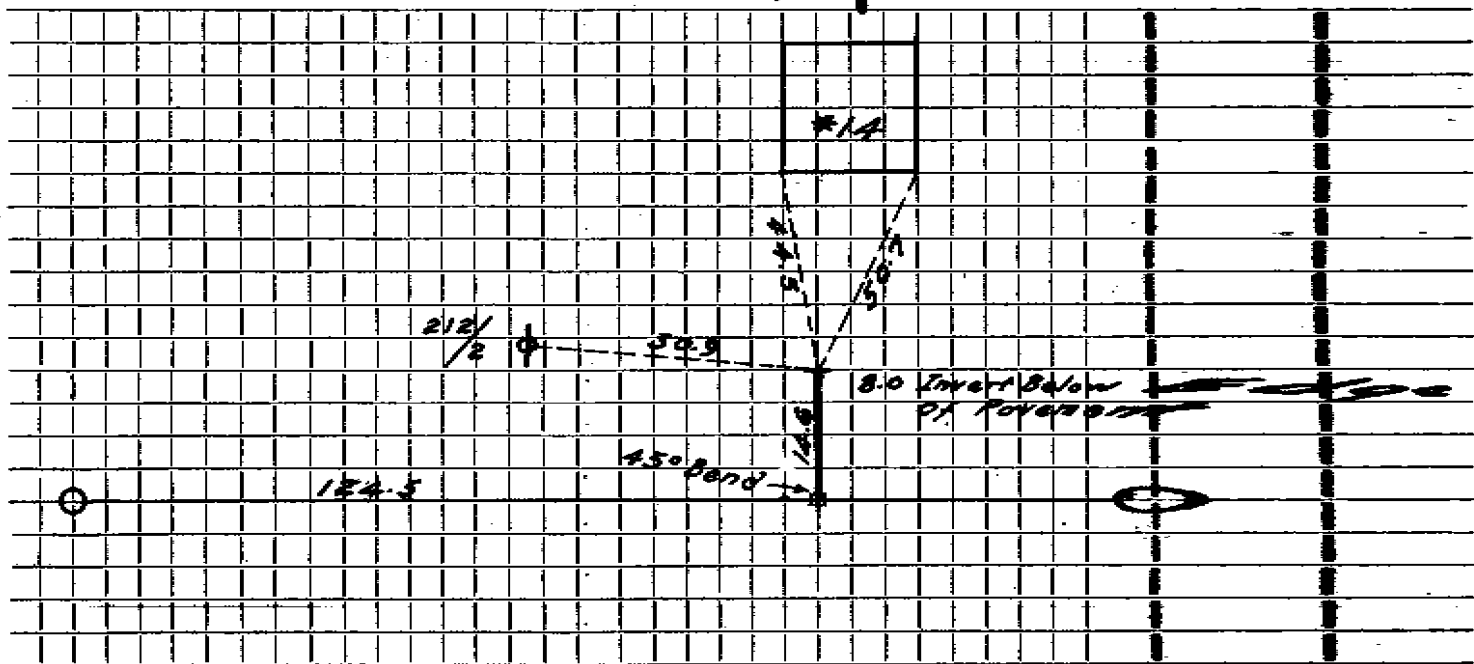

Connection made in Street. Work completed

Remarks:
.....
.....