

Name Robert E. P. Miller

Service No. 148

Address

17 Munroe Rd.

17 Munroe Rd.

Location 17 Munroe Road

Kind of Pipe

Size 6"

Size of Main 8"

~~Revised~~ New Service

W.O.# 8259

Location Cammie 6-18-64


Date	Material	Amount	Total	Date	Amount
<u>2-63</u>	<u>Labor</u>	<u>94.33</u>		<u>16-22-63</u>	<u>Deposit</u>
<u>6-64</u>	<u>10% O.R.</u>	<u>9.43</u>	<u>103.76</u>	<u>6-24-64</u>	<u>Paid</u>
<u>35'</u>	<u>6" Transit pipe #82</u>		<u>28.20</u>	<u>21.3</u>	<u>6" Transit</u>
<u>1</u>	<u>11 1/2" Transite Elbow</u>		<u>2.35</u>	<u>1</u>	<u>6"-45° Bend</u>
<u>10 yds.</u>	<u>Loam #3.00</u>		<u>30.30</u>	<u>1</u>	<u>6" X 8" Wye</u>
<u>3 hrs.</u>	<u>Tom Shovel #6.50</u>		<u>19.50</u>		
<u>2 hrs.</u>	<u>Trucking #3.00</u>		<u>6.00</u>		
<u>1 hr.</u>	<u>Trailer #3.00</u>		<u>3.00</u>		
	<u>Provision Charge</u>		<u>127.80</u>		
			<u>321.11</u>		
				<u>21.3</u>	<u>feet 6" A.C.</u>
					<u>Installed by contractor</u>
					<u>\$6.00 per foot</u>
					<u>127 80</u>
					<u>Bull seat 21.11</u>

DATE _____

TOWN OF LEXINGTON — BOARD OF PUBLIC WORKS
SEWER DIVISION

Sketch of Service Here

17

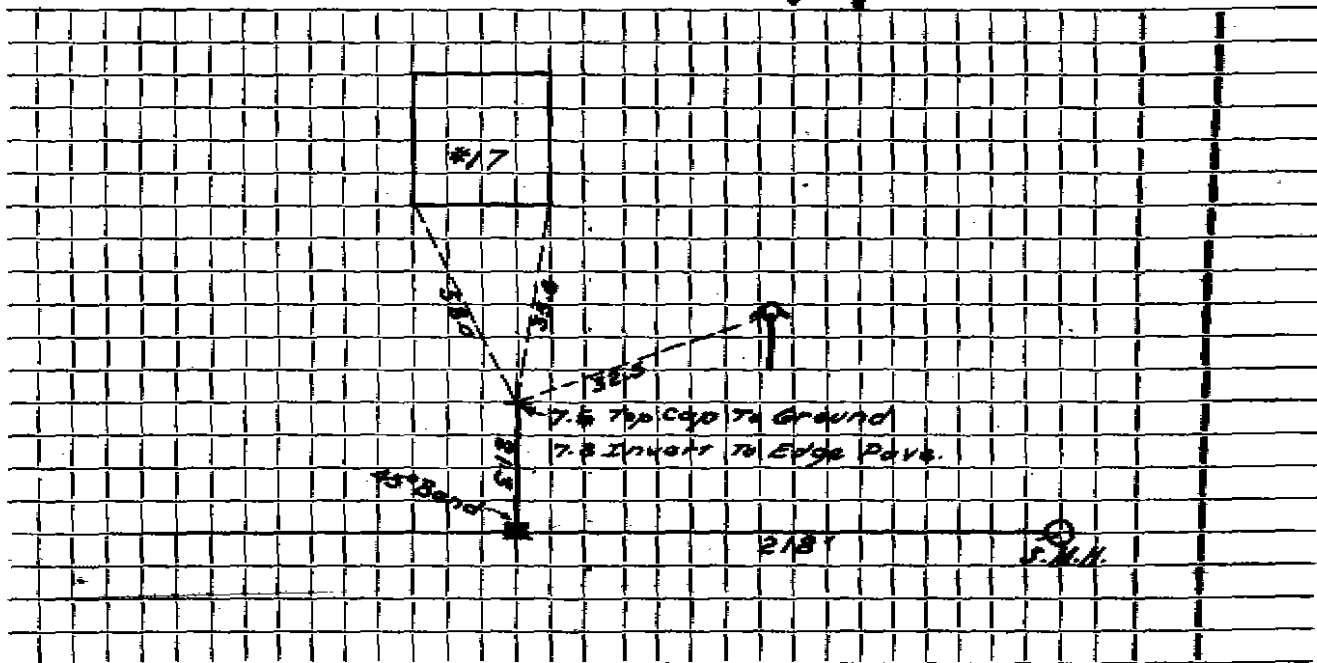

Connection made in _____ Street.

Work completed _____

Remarks: _____