


DATE _____

TOWN OF LEXINGTON — BOARD OF PUBLIC WORKS SEWER DIVISION

Sketch of Service Here

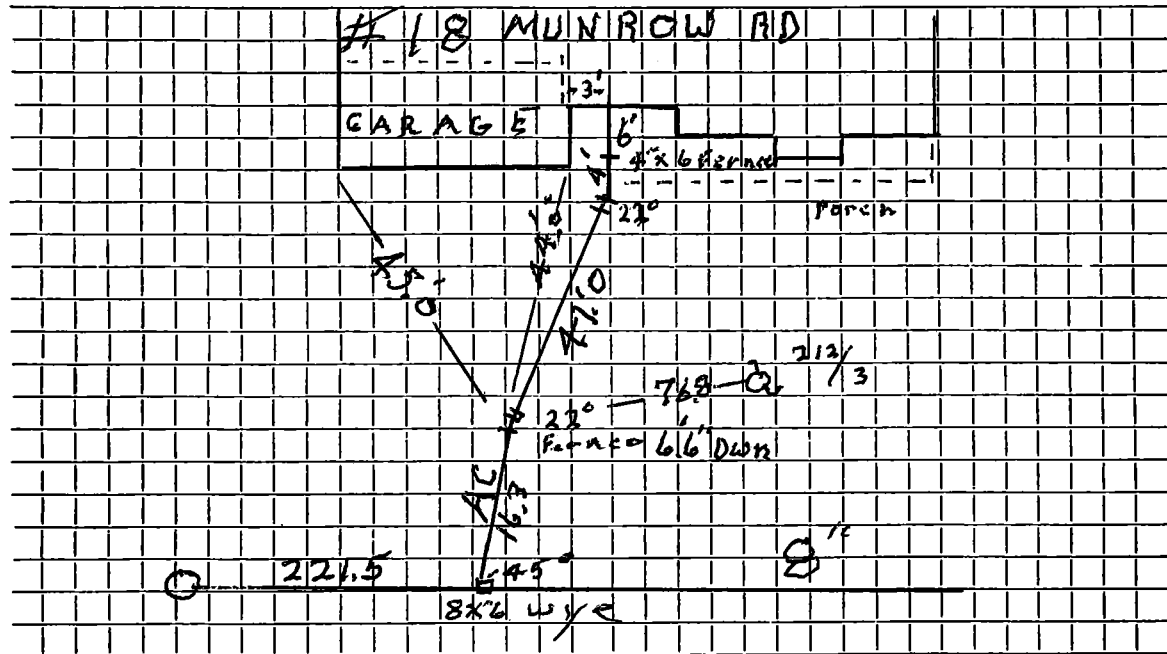

Connection made in Street. Work completed 4/27/10

Remarks: NO Old Sewer Card

.....
.....