

Name **Robert G. Hill**

Service No. **143**

Address **E. J. Munroe Rd.**

**21 Munroe Road**

Location **21 Munroe Road**

Kind of Pipe

Size **6"**

Size of Main **8"**

~~Robert G. Hill~~ New Service **W. H. 8253**

Location **Com. n. 518-63**

Date	Material	Amount	Total	Date	Amount
6-3	LABOR 56.97			10-18-63	
6-3	" 12.32			5-30-64	
6-3	" 20.95	90.24			
	10% O.H.	9.02	99.26	2-13-64	
	30' 6" Transit pipe @82		24.50		
1	bag Cement		1.55		
1	1 1/2" Transit Elbow		2.25		
4	yds. Loam @3.00		12.00		
4	tons Patch @5.50		22.00		
1	hr. Compressor		5.00		
1	hr. Roller		3.00		
1	hr. Tractor @2.00		2.00		
2	hrs. Tom Shovel @6.50		13.00		
3	hrs. Trucking @3.00		9.00		
1	hr. Trojan Loader		4.00		
	Previous Charge		127.80		
			325.56		

*Deposit Paid*

*2 1/2' - 6" Transite  
1 6" - 45° Bend  
1 6" X 8" Wye*

*21.3 feet 6" A.C.*

*Installed by contractor*

*@ 6.00 per foot*

*Bill sent 2-25-64*


TOWN OF LEXINGTON — BOARD OF PUBLIC WORKS

SEWER DIVISION

DATE \_\_\_\_\_

Sketch of Service Here

**21**

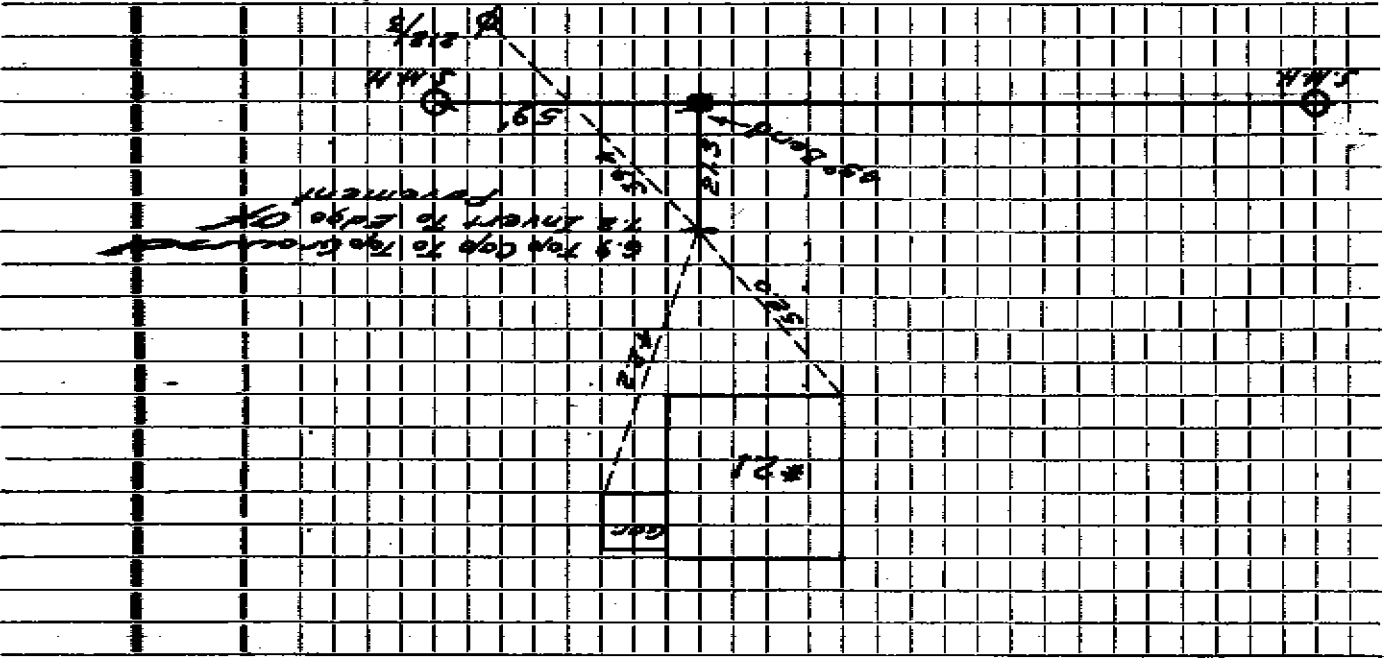

Connection made in \_\_\_\_\_

Street \_\_\_\_\_

Work completed \_\_\_\_\_

Remarks: \_\_\_\_\_