

Name **FRENK D'AMARINO**

Service No. **179**

Address **E E Munroe Rd.**

22 Munroe Rd.

Location **22 Munroe Road**

Kind of Pipe

Size **6"**

Size of Main **8"**

~~REPLACEMENT~~ **NEW SERVICE**

WOFF 8305

Location **CON 5864**


Date	Material	Amount	Total	Date	Amount
4-63	LABOR 41.07			11-14-64	302.00
5-63	" 32.56			Returned	12 1/2
64	" 20.77	94.40	103.84		282.89
	105 G.H.	9.44	1.55	16.3-6" TRANSITE	
1	base Cement		24.60	1 6"-45° Elbow	
30'	6" Transite pipe #82		2.35	1 6"X8" Wye	
1	11" Transite Elbow		22.75		
3 1/2	hrs. Town Shovel #6.50		3.00		
2	hrs. Trucking #7.00		27.00		
9	hrs. Labor #3.00		97.80	16.3 feet 6" A.C.	
	PEAYLOW Charge		282.89	Installed by contractor	
				@ 6.00 per foot	97.80

DATE _____

TOWN OF LEXINGTON — BOARD OF PUBLIC WORKS
SEWER DIVISION

Sketch of Service Here

22

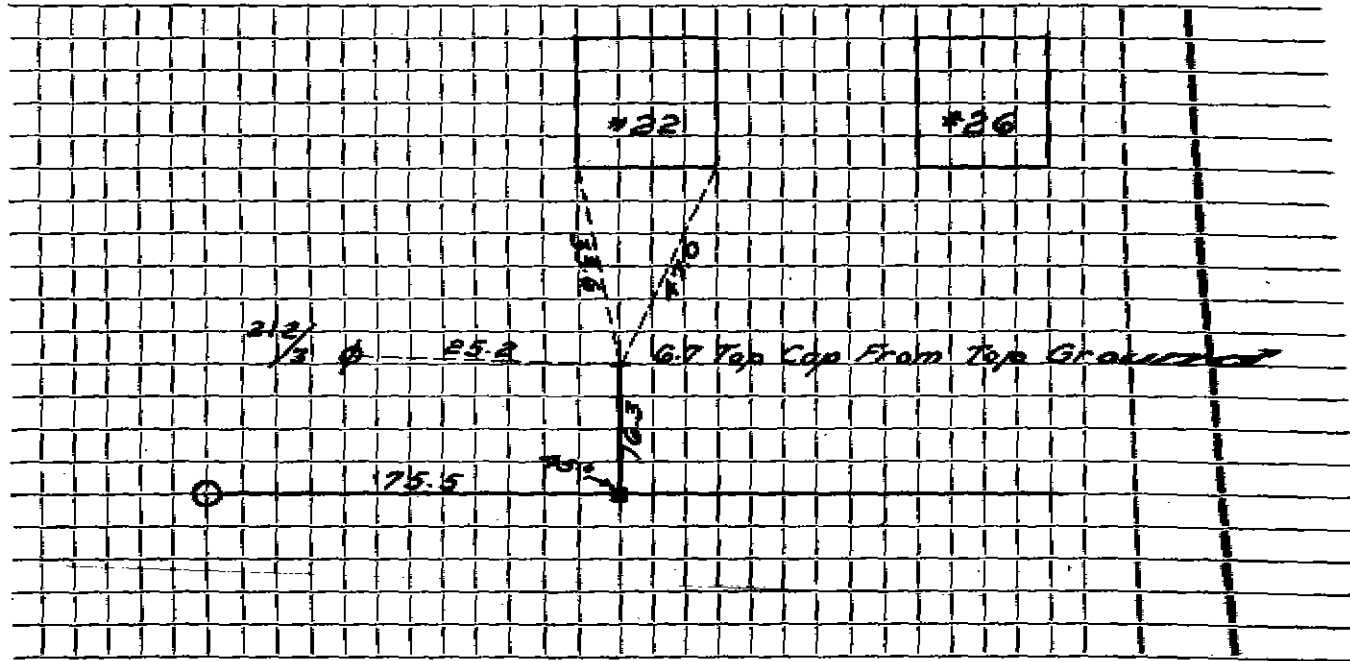

Connection made in Street. Work completed

Remarks:

.....

.....