

Name Charles E. Harris

Service No. 188

Address 26 Monroe Rd.

Location 26 Monroe Road

Kind of Pipe Kind of Pipe

Size 6"

Size of Main 8"

~~XXXXXXXXXXXXXXXXXXXX~~ New Service

W. C. H. 8318

Location Chap. 111-44


Date	Material	Amount	Total	Date	Amount
9-64	LABOR	62.56		11/15/63	Deposit
	10% O.H.	6.26	68.82	5-14-64	Retrad
	30' 6" Transit pipe @ \$2		24.00		163-6" Transit
	1 bag cement		1.55		1 6"-45° Bend
	4 yds - Linn @ 3.00		12.00		1 6" x 8" Wye
	1 1/2 x 3 Patch		15.00		
	3 hrs - Town Shovel @ 6.50		19.50		
	1 hr - Trucking @ 3.00		3.00		
	Previous Charge		97.80		
			242.27		
					16.3 feet 6" A.C.
					installed by contractor
					@ 6.00 per foot
					97.80

DATE \_\_\_\_\_

TOWN OF LEXINGTON — BOARD OF PUBLIC WORKS

SEWER DIVISION

Sketch of Service Here **26**

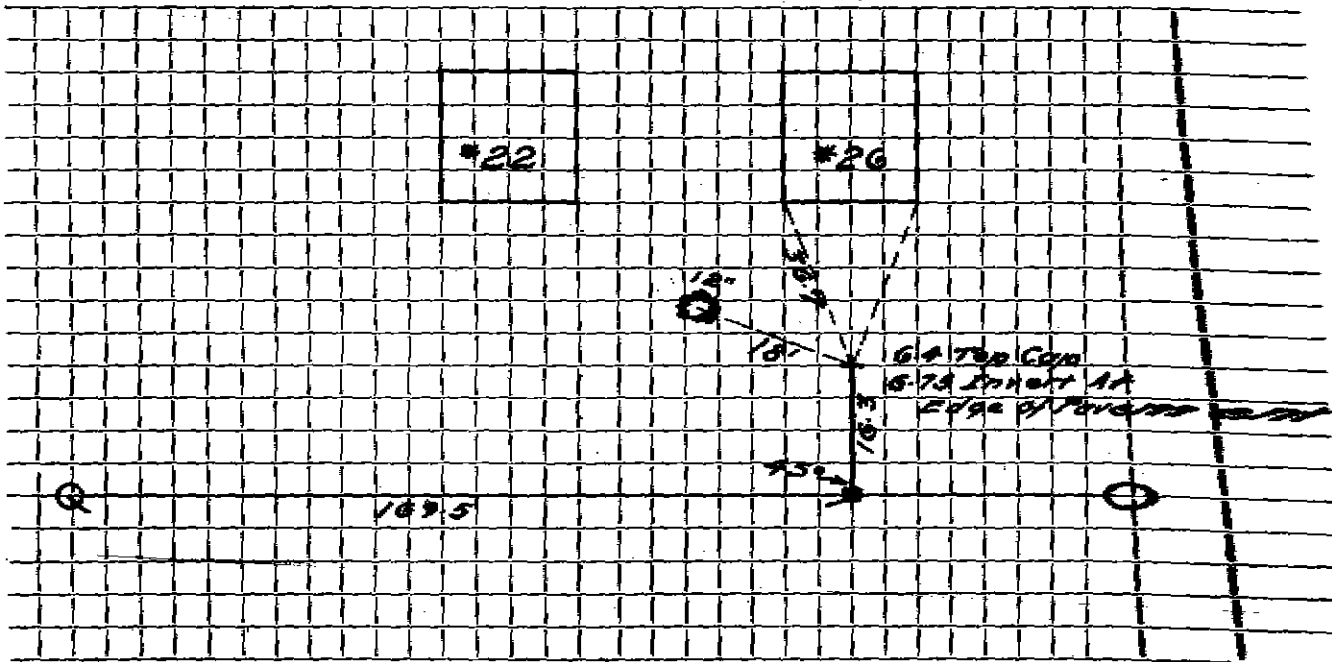

Connection made in ..... Street: Work completed .....

Remarks: .....  
.....  
.....