

Name Stephen H. Dimmock

Service No. 186

Address 29 Munroe Rd.

Location 29 Munroe Road

29 Munroe Rd.

Kind of Pipe 4-6.9 Deep

Size 6"

Size of Main 8"

~~SEWER SERVICE~~ New Service No. # 8317

Location Comm 5-18-64

Date	Material	Amount	Total	Date	Amount
8-63	Labor 29.44			11-15-63	300.00
0-63	" 46.66			6-21-64	31.48
-64	" 15.84	91.94			331.48
	10% O.H.	9.19	101.13		
30'	6" Transite pipe @82		24.60		
15	yds. Loam @3.00		45.00		
1	bag Cement		1.55		
4	hrs. Trucking @3.00		12.00		
4	hrs. Town Shovel @6.50		26.00		
	Previous Charge		121.20		
			331.48		
					20.2 feet 6" A.C. installed by contractor @ 6.00 per foot
					121.20


20.2' 6" Transite
1 6"-45° Bend
1 6" X 8" Wye

B/L 5-11-64

DATE _____

TOWN OF LEXINGTON — BOARD OF PUBLIC WORKS
SEWER DIVISION

Sketch of Service Here **29**

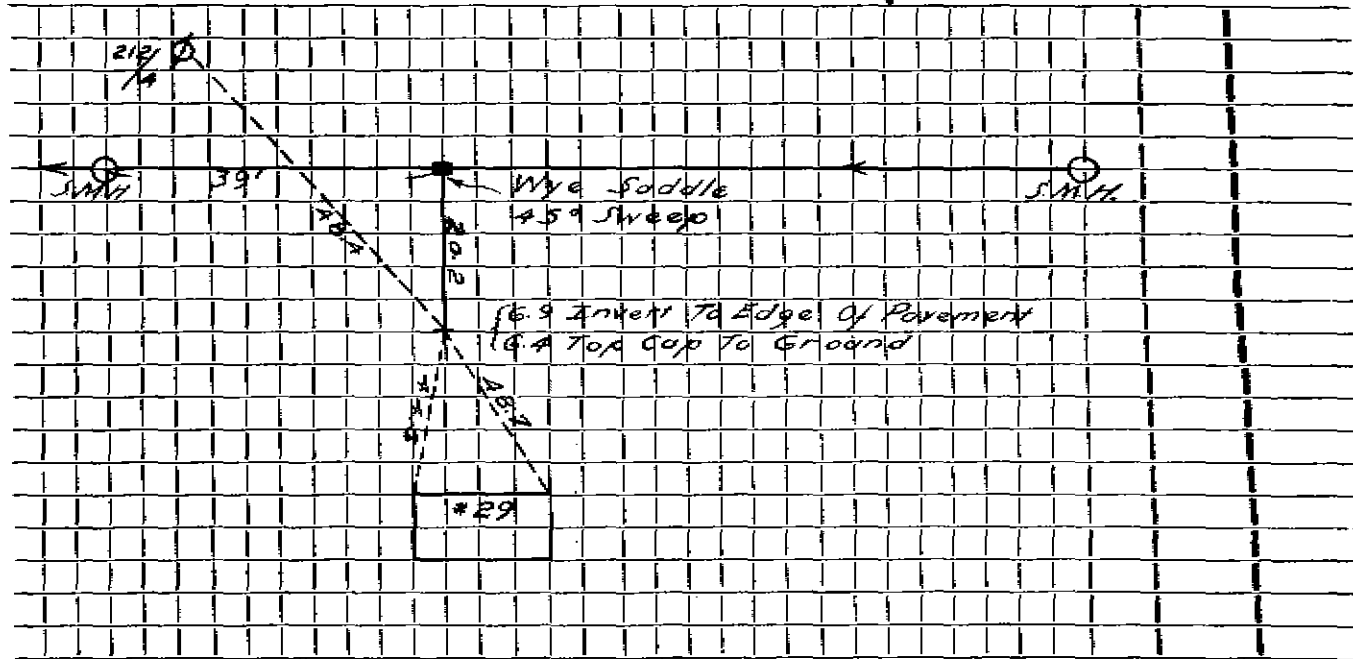

Connection made in Street. Work completed

Remarks:

.....

.....