

Contractor **J. J. Manning**

Service No. **150**

Address **30 Murray Rd.**

30 Murray Rd.

Location **30 Murray Road**

Kind of Pipe

Size **6"**

Size of Main **8"**

~~REPLACEMENT~~ New Service **W.O.F. 8262**

Location **Comm. 5-18-64**

Date	Material	Amount	Total	Date	Amount
4-63	Labor 28.89			10-22-63	
4-63	" 35.22			5-18-64	
6-64	" 15.84	79.95			
	10% O.R.	8.00	87.95		
	30' 6" Transite pipe @82		24.60	6-2-60	
	1 bag Cement		1.55		
	1 1 1/2" Transite Elbow		2.35		
	3 hrs. Tom Shovel @6.50		19.50		
	2 hrs. Trucking @3.00		6.00		
	4 yds. Loan @3.00		12.00		
	1 1/2 ton Patch @5.50		8.25		
	1 hr. Roller @3.00		3.00		
	Previous Charge		115.80	2-22-64	
			281.00		

Deposit
Retread

300.00
19.00
281.00

OUTSIDE V.O. #1052

Labor

6" x 5' Nipple

22 1/2" Bend Shovel
hrs. Fernco Coupling
hrs. Trucking
yds. Gravel

19.3 Feet 6" A.C.

installed by contractor

@6.00 per foot

115.80


last 30' cut from house

DATE _____

TOWN OF LEXINGTON — BOARD OF PUBLIC WORKS

SEWER DIVISION

Sketch of Service Here **30**

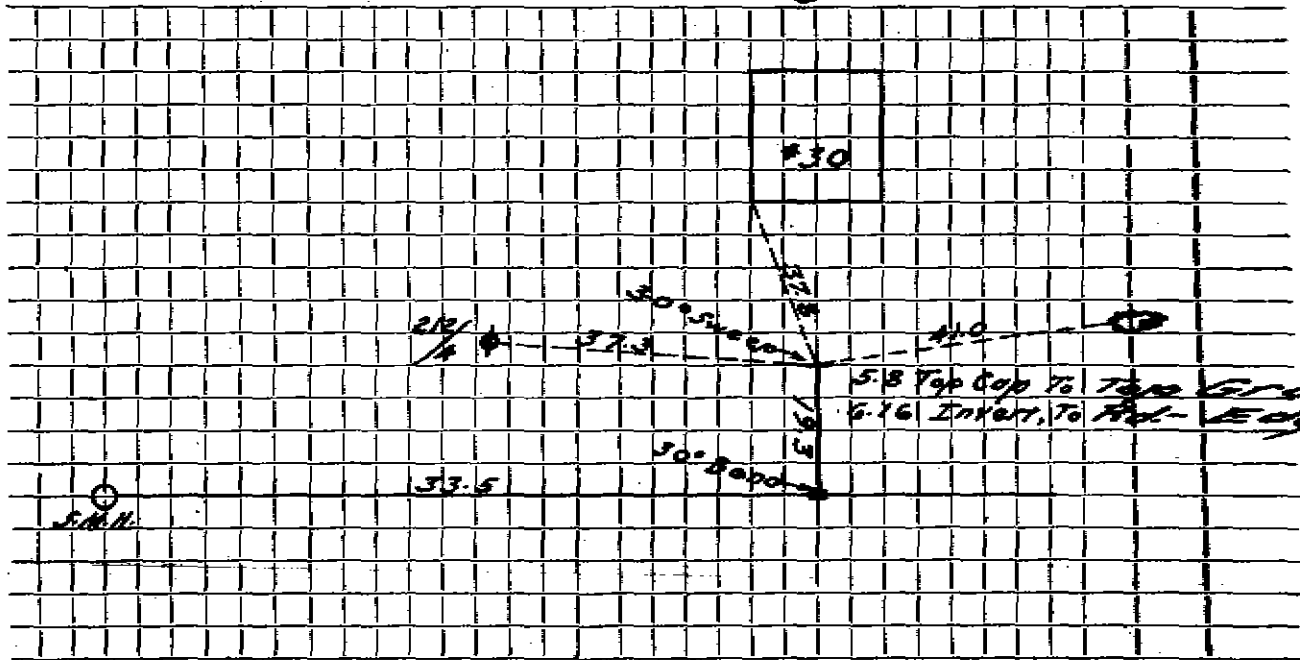

Connection made in Street. Work completed

Remarks:
.....
.....