

Name **Lee Zwicker**

Service No. 19

Address *37 Munroe Road*

**37 Munroe Rd.**

Location 37 Munroe Road

Kind of Pipe

Size **6"**

Size of Main **8"**

~~REPAIR SERVICE~~ New Service Trebino #3973

Location JUN 23 1980

Date	Material	Amount	Total	Date	Amount
-/63	<del>21.3' 6" A.C.</del> installed by contractor @ 6.00 per foot	127 80		5-16-80	127 80
	BILL WHEN CONNECTED			10- - 63	
/80	40' 6" Transite pipe			21.3' 6" Transite	
	5' 4" Cast Iron pipe			1 6"- 30° Bend	
				1 6"X8" Wye	


DATE \_\_\_\_\_

TOWN OF LEXINGTON — BOARD OF PUBLIC WORKS

SEWER DIVISION

Sketch of Service Here

37

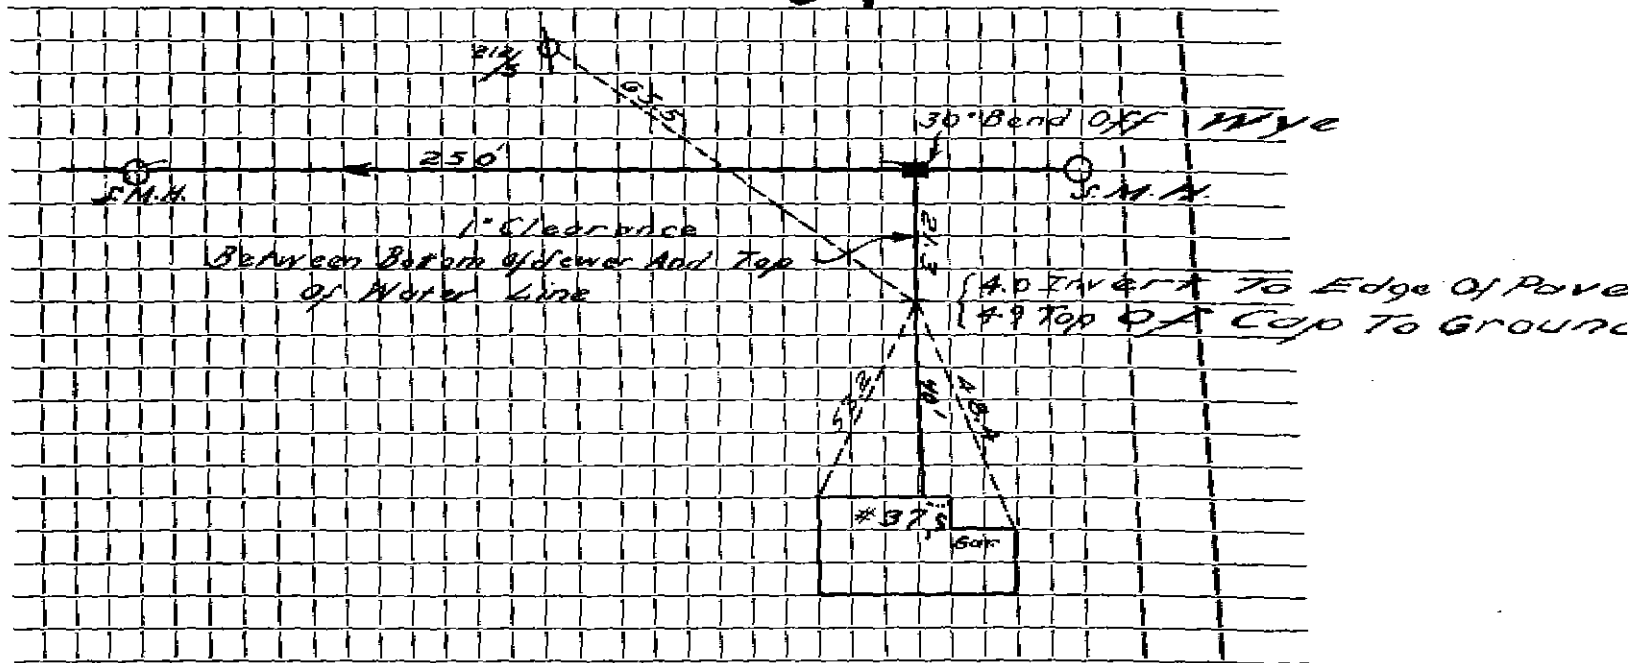

Connection made in ..... Street. Work completed .....

Remarks: .....

.....

.....