

Service No. 144

Name William B. Gifford

Address 38 Monroe Rd.

38 Monroe Rd.

Location 38 Monroe Road

Kind of Pipe Size 6" Size of Main 8"

REPAIR WORK - New Service 10 Oct 1963

Location C 5-18-64

Date	Material	Amount	Total	Date	Amount
14-63	Labor 42.34			10-21-63	
15-63	" 174.61	59.95	65.95	5-18-64	225.00
	10% O.H.	6.00	26.24	11-19-63	53.53
	32" 6" Transite pipe @ .82		1.55	15-2-63	222.48
1	bags Cement		12.00	6"-6" Transite	
4	yds. Loom @ 3.00		19.50	1 6"-45" Bend	
3	hrs. Tom Shovel @ 6.50		6.00	1 6"x8" Wye	
2	hrs. Trucking @ 3.00		91.20	15.2' feet 6" A.C.	
	Provisions Charge		222.48	installed by contractor	
				@ 6.00 per foot	
				91.20	


TOWN OF LEXINGTON — BOARD OF PUBLIC WORKS

SEWER DIVISION

DATE _____

Sketch of Service Here

38

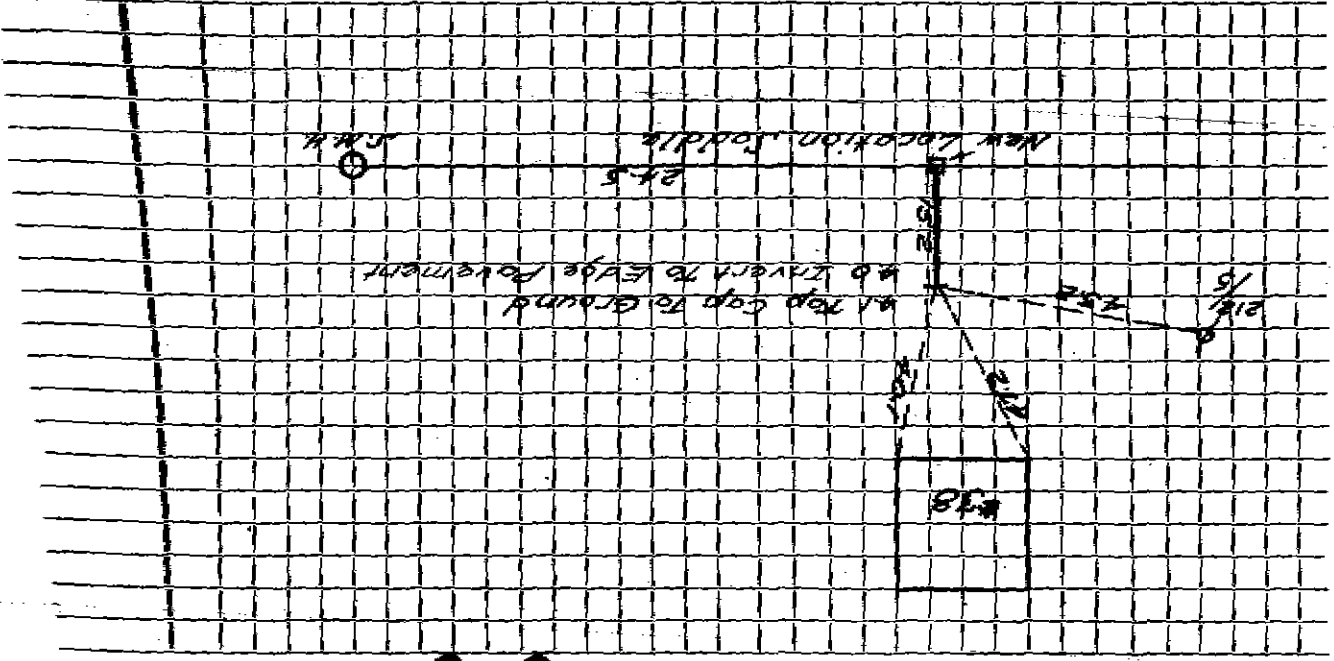

Work completed

Street.

Connection made in

Remarks: