

Name

Eric Michelson

Service No.

Address 46 MUNICE ST.

46 Munroe Rd.

Location

Kind of Pipe

Size 6"

Size of Main 8"

Repair-Renewal-New Service

McLaughlin #0357

Location

Date

7/22/94

Material

30 LF 6" PVC

6 LF 4" PVC

4" x 6" FEEDER

Amount

Total

Date

3-4-65

21' 6" TRANSITE

1 6" x 8" WYE

Amount

OK


OK

DATE 7/22/94

TOWN OF LEXINGTON — BOARD OF PUBLIC WORKS
SEWER DIVISION

Sketch of Service Here

46

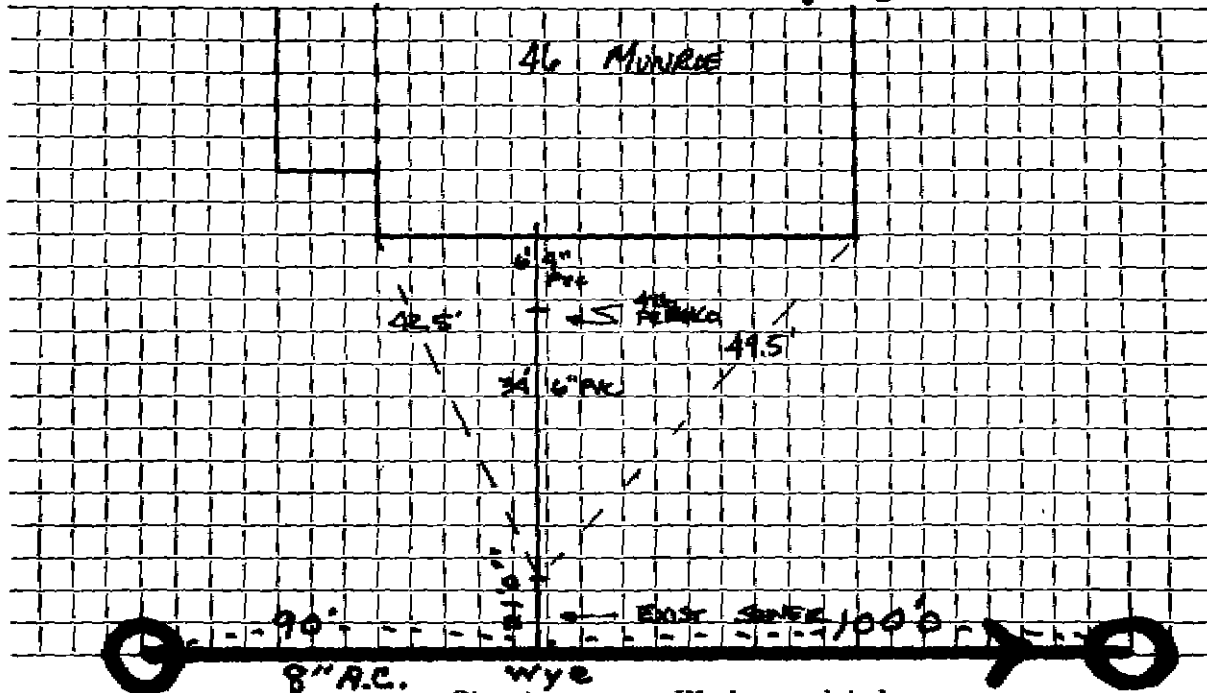

Connection made in Street. Work completed

Remarks:

.....

.....