

Name Hannah Delfiner

Address 49 Munroe Road

19 Munroe Rd.

Location

Kind of Pipe DEP & PVC

Size 6"

Size of Main 8" ACP

~~Inspector~~ New Service Valeri #3939

Location FEB 19 1965


Date	Material	Amount	Total	Date	Amount
2-5-65	6" Transite pipe @ \$5.00		105.00	11-20-64	105.00
4	6" x 6" PVC			3-5-65	
1	6" x 4" Donut			21'	6" Transite
1	6" Wye			1	6" x 8" Wye
1	6" x 22 1/2° Elbow				
250	Red Sewer Brick				
	Frame & Cover				

DATE MARCH 1965

TOWN OF LEXINGTON — BOARD OF PUBLIC WORKS
SEWER DIVISION

Sketch of Service Here

49

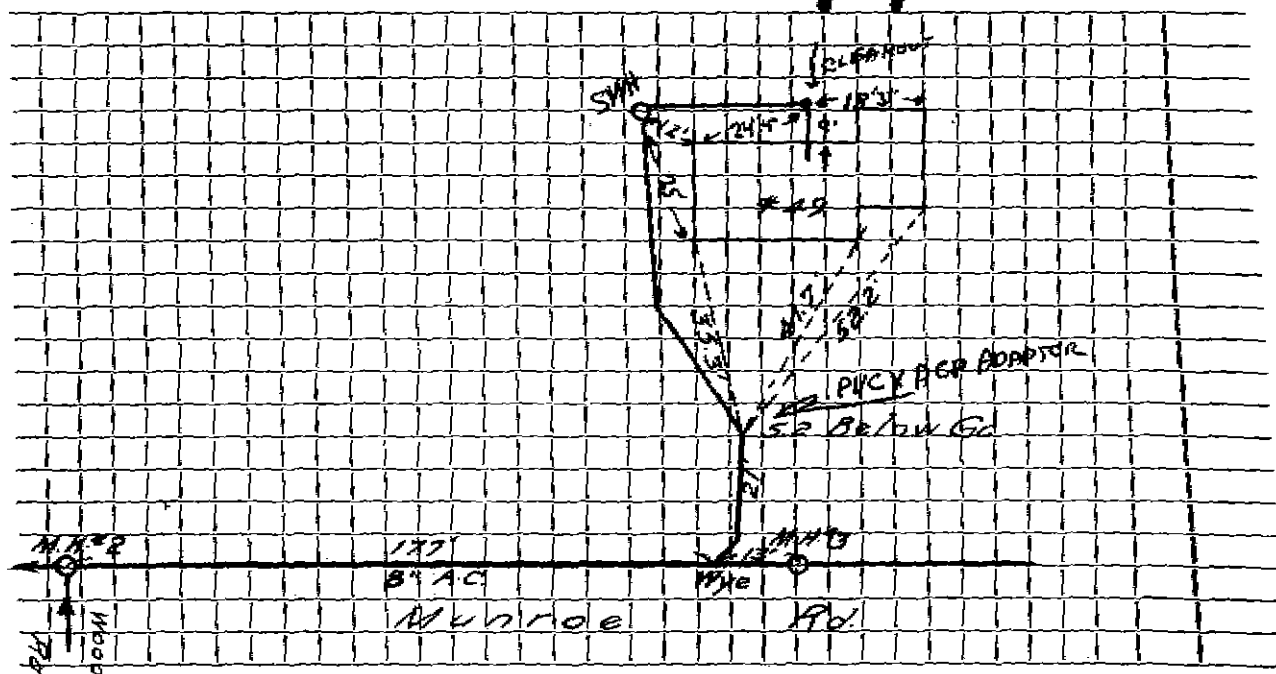

Connection made in MUNroe RD Street. Work completed DEC 2, 1964

Remarks: